



DISTRICT FARIDABAD

LAYOUT PLAN OF UNNAMED COLONY ID-7233_4 IN THE REVENUE ESTATE OF VILLAGE SEHATPUR, Tehsil-FARIDABAD, DISTRICT-FARIDABAD COMPRISING IN KHASRA NO. 22/12 min 3

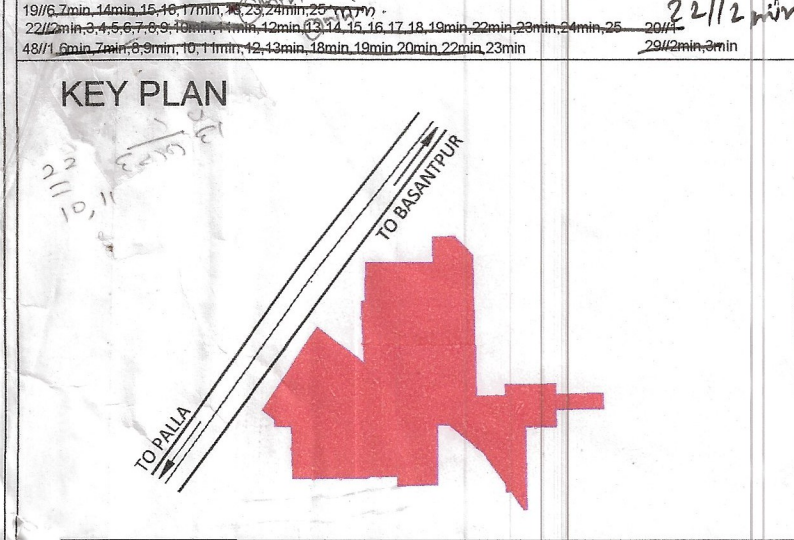

DETAILS OF UNAUTHORIZED COLONY		
Sr. No.	Parameter Name	Description
1	Colony name	UNNAMED COLONY ID-7233_4
2	Area	40.786 Acres
3	Location of the colony	Near Deeksha Public School Sector D
4	(i) Within MC	Yes
	(ii) Outside MC	No
4	Type of Colony and use (in %)	Residential 39.76% Commercial 14.40%
5	Controlled Area	Additional controlled area around dist of Agra Canal Pocket B
6	Urban Area	FARIDABAD
7	Year of establishment	2000
8	Layout Plan (Scale)	1:1000
9	Total Plots	NA
10	Constructed Plots (Residential-Commercial)	183(R)-63(C)
11	Number of vacant plots	NA
12	Number of families residing in the colony	183
13	Does the colony have street light?	No
14	Does the colony have water supply through pipelines?	No
15	Does the colony have underground sewerage facility?	No
16	If connected to any external Sewage treatment plant? (Y/N)	No
17	Does the colony have Park or Open space	NA
18	Road type on Colony (kacha/pucca)	Pucca
18	Width Of Different roads (in meters)	Road Width Length (in mtrs)
	4M	255M
	5M	218M
	6.5M	202M
	7M	715M
	8.50M	83M
19		9.00M 1388M
		10M 911M
		12M 883M
		11M 161M
		14M 744M
19	Minimum Road width	4M
20	Electricity provided to households through which sub station	Palla
21	Does the colony have community site	No
22	Area of the community site(in acres)	Nil
23	Is the RWA registered	NA
24	Additional Information, if any	
NOTICE ISSUED ON PARTIAL LAND, IT IS T.P SCHEME NAMED SURYA NAGAR ADJOINING LICENCED COLONY NAMED DURGA BUILDER		

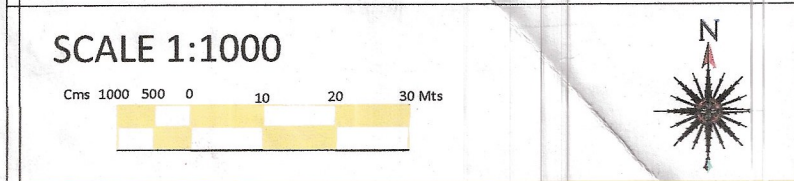

DRONE SURVEY AND LAYOUT PLAN PREPARED BY:- PD CONSULTING ENGINEERS PVT.LTD

hello@pdcegroup.com www.pdcegroup.com
Red House, Behind MCD School, Mehrauli-Gurgaon Rd, Ghitorni, Delhi - 30

Checked : PDCE	Surveyor : RISHI PAL	Sheet :- A0
Drawn By: NAYAB	Shl. No. :- 1 OF 1	ID-7233_4

NOTE:
ALL DIMENSIONS ARE IN METERS AND AREA IN ACRES

DRG. NO. DTP(E)-FBD/2022/ DATED

LAYOUT PLAN CHECKED AND VERIFIED AT SITE BY:- PATWARI



JUNIOR ENGG.

ASSISTANT TOWN PLANNER

DISTRICT TOWN PLANNER

SENIOR TOWN PLANNER

OFFICE-DISTRICT TOWN PLANNER(ENF), FARIDABAD TOWN & COUNTRY PLANNING DEPTT., HARYANA

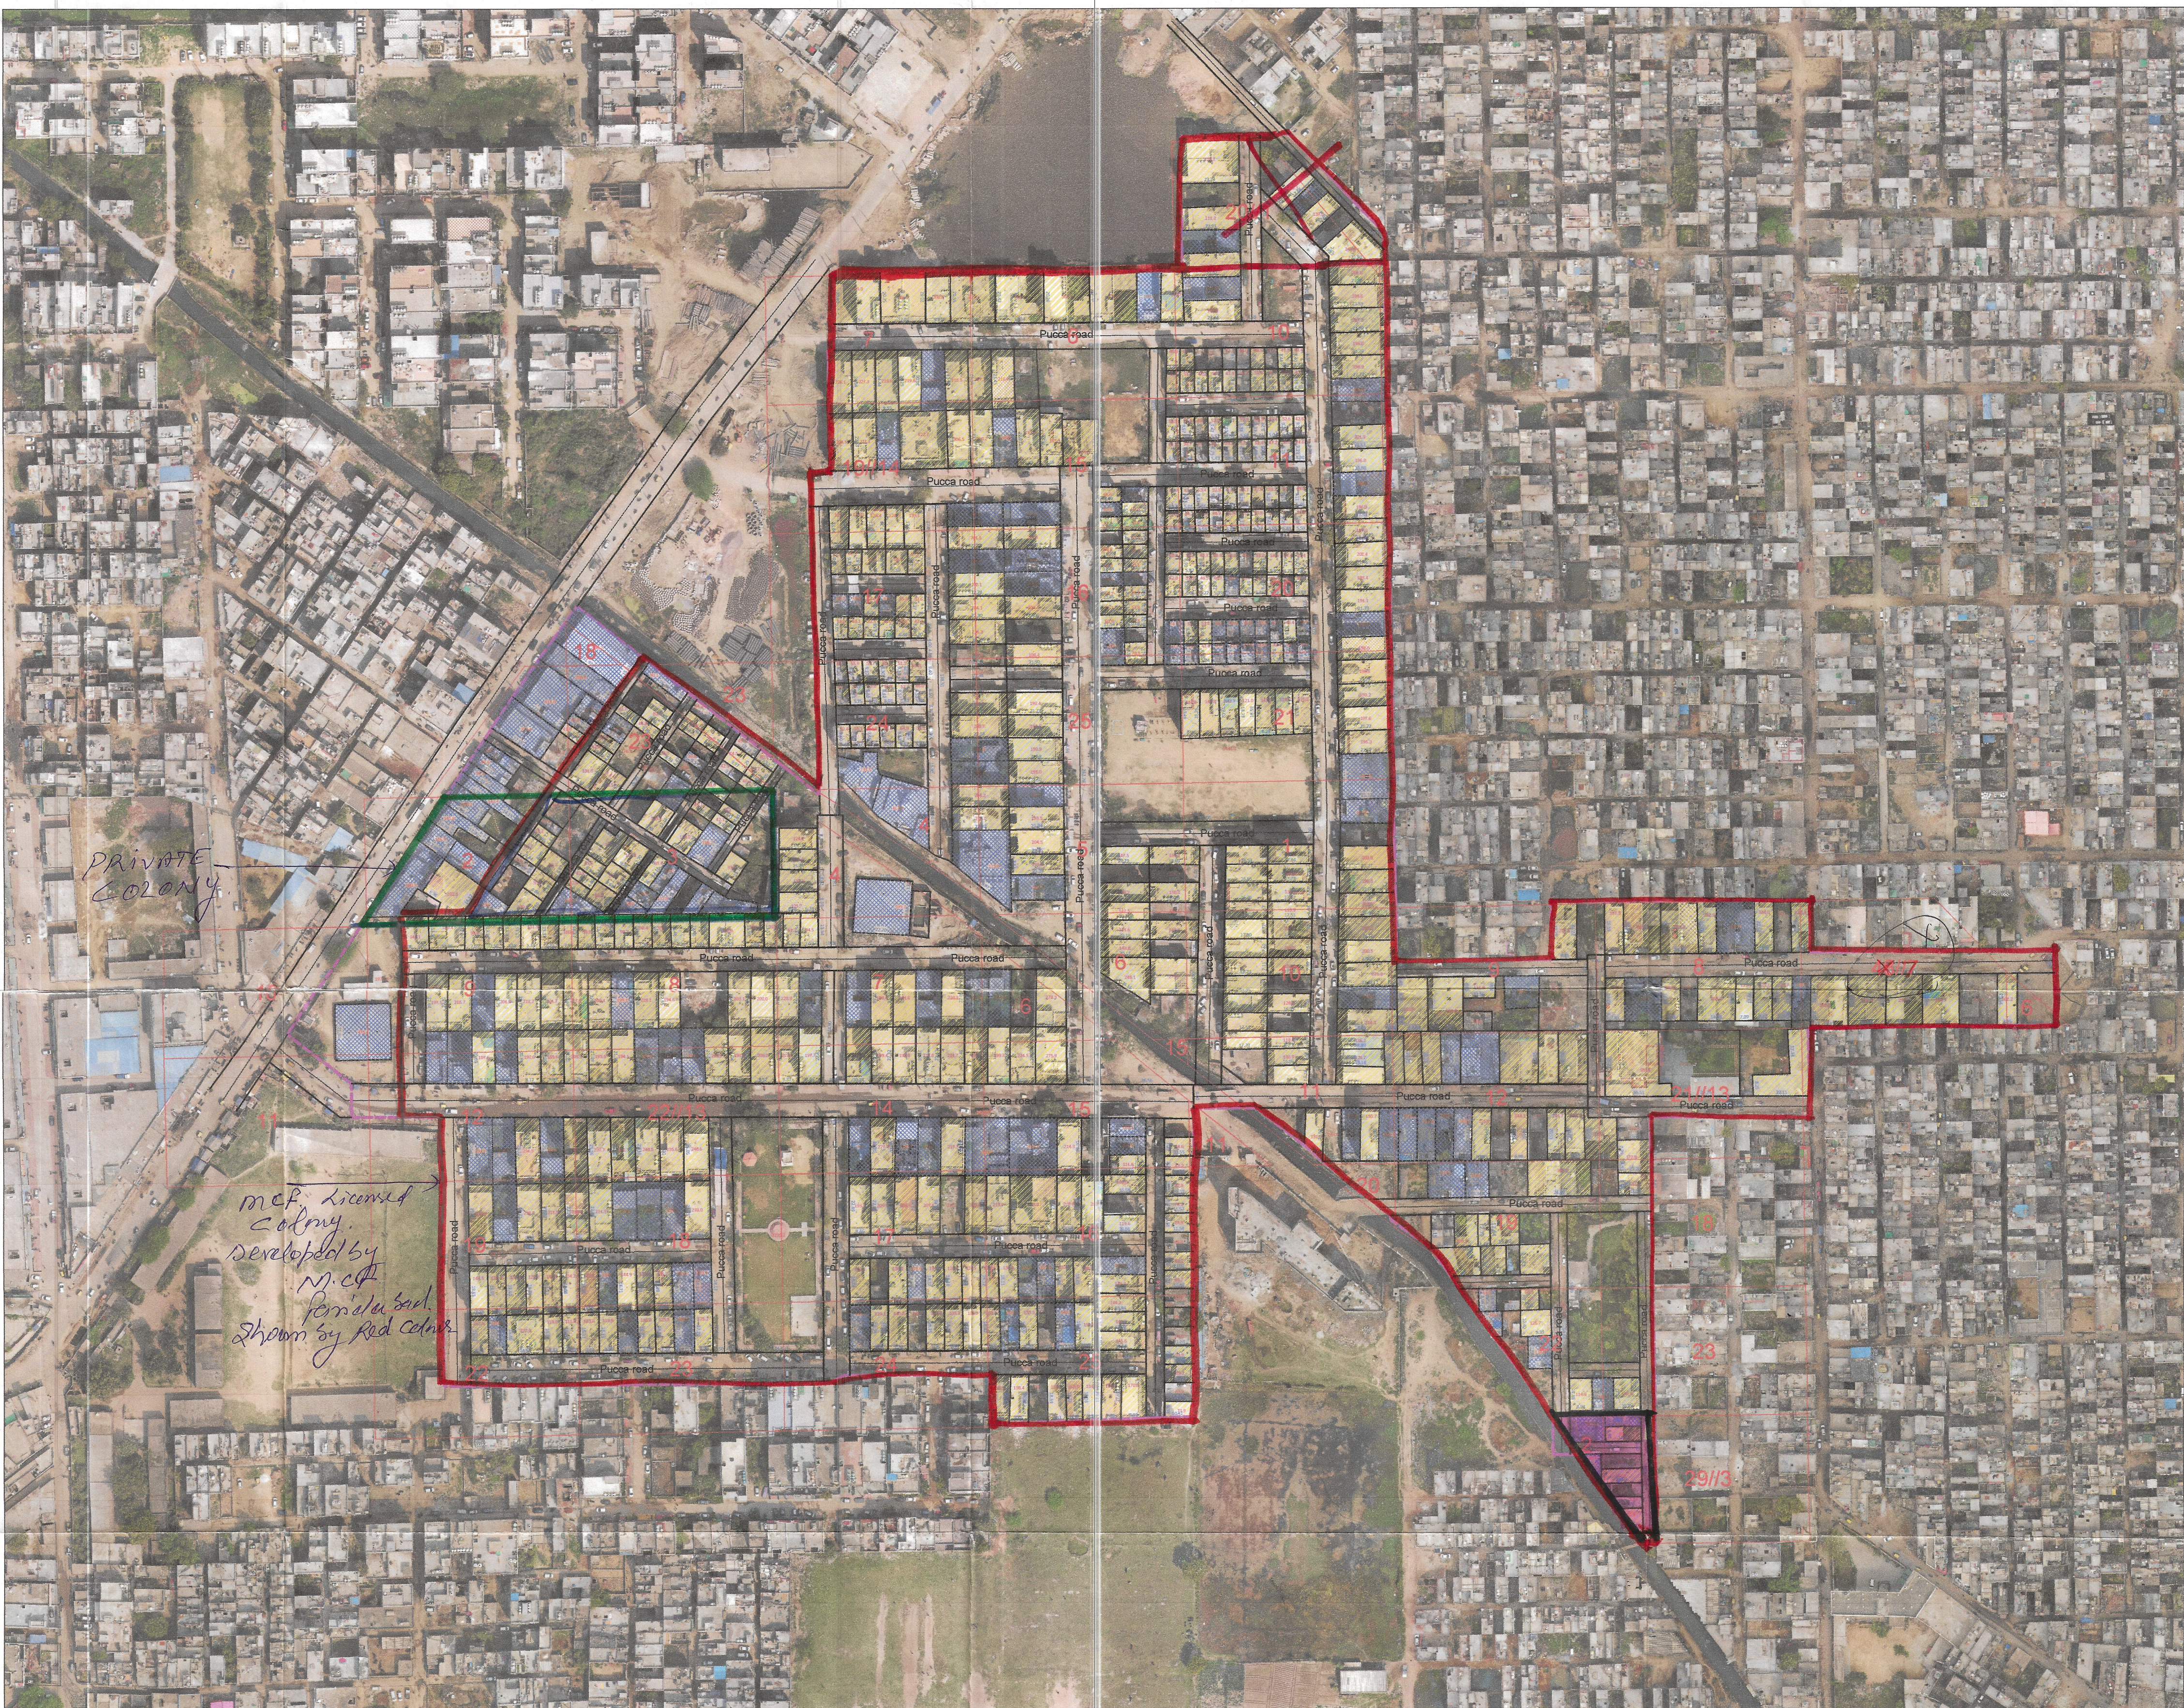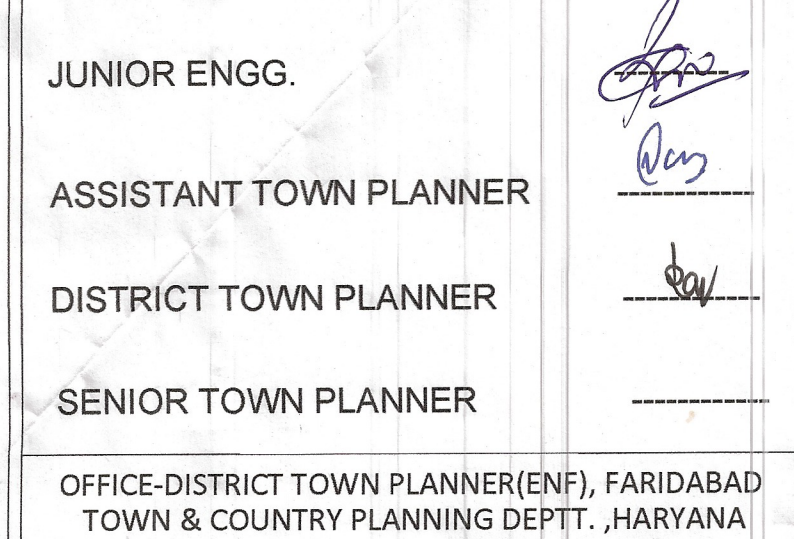

LEGEND					
Murraba Line		Commercial Area		Industrial Area	
Manhole/ Chamber		Built Up Area/Residential		Vacant Plot (Not to be Regularised)	
TF/Electric/Mobile tower		Vacant Land/Plot		Public & Semipublic Area	
Street Light/Solar pole		HT Line		Divider Road	
Revenue Boundary		Sewerage Line		Temple/Mosque/Church/Flag Post	
City Road		Water Supply Line		Statue/School/Airport/Hospital/Well	
				Tin Shed	

-161- S.NO-38

Note!-0 Demarcation of Site by Red Colony.

(2) Area of Site!-39.188 Acres

Kh. No!- 20/12 min 10, 11, 20, 21 min, 19/16 7 min, 14 min, 15, 16, 17 min, 23 min, 22/12 min, 3, 5 min, 6 min, 7, 8, 9 min, 12 min, 13, 14, 15, 16, 17 min, 18 min, 19 min, 22 min, 23 min, 24 min, 25 min, 21/12, 20, 11 min, 12, 13 min, 14 min, 15 min, 1478 min, 1479