


DISTRICT SIRSA

LAYOUT PLAN OF UNAUTHORISED COLONY
NEAR GALI NO.14 IN THE REVENUE ESTATE OF VILL KHALA KHERA
TEH, SIRSA . DIST, SIRSA

KHARSA NO. - 22

75// 84//2,3,4,5,6,7,8,9,13,14,15,
16min,17,18

KEY PLAN

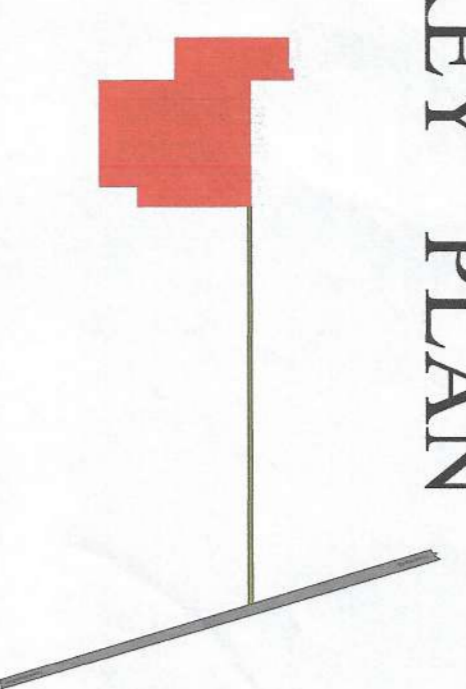

DETAILS OF UNAUTHORISED COLONY

| Sr. No. | Parameter Name | Description |
|---------|--|---|
| 1 | Colony name | UC-S-55 (Part A) |
| 2 | Area | 14.14 Acres 57211.83 SQ.M Near Gal. No.14 |
| 4 | Location of the colony | (1) Within MC No (2) Outside MC No (3) Partial MC Yes |
| 5 | Municipal Limits Boundary (MC Status) | Yes |
| 6 | Name of Revenue Estate | Sirsa |
| 7 | District Name | Sirsa |
| 8 | Name of Controlled Area | Sirsa |
| 9 | Urban Area | Sirsa |
| 10 | Year of establishment | 2015 |
| 11 | Total No. of Plots | 65 |
| 12 | No. of Constructed Plots (Residential + Commercial + Industrial) | 47+0+0=47 |
| 13 | Number of vacant plots | 18 |
| 14 | Number of families residing in the colony | 47 |
| 15 | Does the colony have street light? | No |
| 16 | Does the colony have Electric line | Yes |
| 17 | Does the colony have H.T. Line | No |
| 18 | Does the colony have water supply through pipelines? | Yes |
| 19 | Does the colony have underground sewerage facility? | No |
| 20 | Does the colony have Park or Open space | No |
| 21 | Road type on Colony (Kuchha/Pucca) | Partial Kuchha/Pucca |
| 22 | Different roads (in meters) | Road Width Length (in mtrs) |
| | Pucca Road | 0 M 0 |
| | Kuchha Road | 3.7 M to 7.7 M 1655.4 M |
| 23 | Minimum Road width | 3.7 M |
| 24 | Area of the community site(in acres) | No |
| 25 | Is the RWA registered | No |
| 26 | Additional Information, if any | No |
| 27 | Name of Electric Sub station | Sirsa |

DRG. NO. D.T.P. (S) DT.

LAYOUT PLAN CHECKED AND VERIFIED AT SITE BY
PATWARI :-

FIELD INVESTIGATOR :-

JUNIOR ENG. :-

ASSISTANT DRAFTSMAN :-

DISTRICT TOWN PLANNER :-


SENIOR TOWN PLANNER :-

OFFICE OF DISTRICT TOWN PLANNER, SIRSA
TOWN & COUNTRY PLANNING DEPT., HARVANA



PRODUCED BY AN AUTODESK EDUCATIONAL PRODUCT

This layout plan of the unauthorized colony is prepared in accordance with the provisions of the Government of India, Ministry of P.W.D., New Delhi, vide notification no. 8019/2014-4-C, 11 dated 07 February, 2014. The plan is subject to the approval of the competent authority.

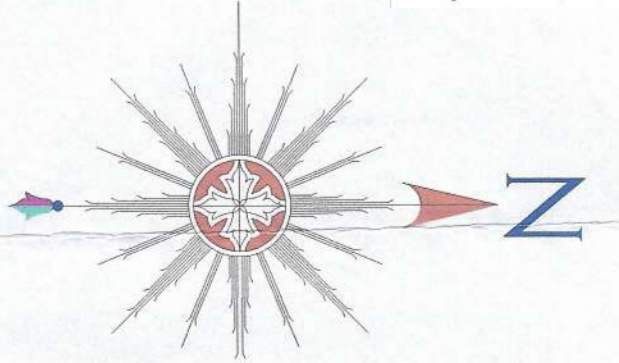

LEGEND

| | |
|--|----------------------|
| | Airport |
| | Electric Pole |
| | Hospital |
| | Manhole |
| | Mobile Tower |
| | Mosque |
| | School/College |
| | Solar Pole |
| | Street Light |
| | Temple |
| | Transformer |
| | HT Line |
| | LT Line |
| | Kuchha Road |
| | Major Road Line |
| | Drainage |
| | Sewerage Storm Water |
| | District Boundary |
| | Internal Colony Road |
| | Residential |
| | Commercial |
| | Industrial |
| | Semi Public |
| | Plot Boundary |
| | Vacant Land |
| | Park |
| | Colony Boundary |
| | Khasra Boundary |
| | MC Boundary |
| | District Boundary |

NOTE :-

1. ALL DIMENSION AREA IN METERS AND AREA IN SQUARE METERS.
2. AREA OF RESIDENTIAL BUILDINGS IS INDICATED THROUGH PINK COLOUR.
3. AREA OF PLOT BOUNDARY IS INDICATED THROUGH PURPLE COLOUR.

SCALE : 1:1 CM = 10 M

LAYOUT PLAN PREPARED BY :-

Technifra SOLUTIONS
1st Floor, R.K. Talwar, Old Bus Stand,
5th Road, Narnaud, Harar-125039, Haryana (India)
91-9812822289 | Email: sandeep.technifra@gmail.com
Website: http://www.technifra.in

| Checked: | Drawn By: | Scale: | Sr. No.: | Rev. No.: |
|----------|-----------|--------|----------|-----------|
| | | | | |

PRODUCED BY AN AUTODESK EDUCATIONAL PRODUCT

Municipal Commissioner
Municipal Council, Sirsa

Executive Officer
Municipal Council, Sirsa

Executive Engineer
Municipal Council, Sirsa

Junior Engineer
Municipal Council, Sirsa

Assistant Engineer
Municipal Council, Sirsa

Technifra
SIRSA