DISTRICT JIND

LAYOUT PLAN OF UNAUTHORIZED COLONY NEAR BRANCH HANSI CANAL IN THE REVENUE ESTATE OF SAFIDON TEH.SAFIDON AND DIST. JIND

1

KHASRA NO




Sr. No.	Parameter Name		Description Safidon UC 12		
1	Colony name				
2	Area	10.07 A	10.07 Acres 40746.34 Sq./N		34 Sq./M
3	Location of the colony		Near Branch Hansi Canal		
-	ESCATION OF the GOOTY	(i) Within MC Yes			
4	Municipal Limits Boundary (MC STATUS):	(ii) Outside MC	No		
		(iii) Partial MC		No	~
	,		Area (%)	Area(Acres)	Area(SQ
		Residential	7%	0.66	2654.0
		Vacant + Open	52%	5.25	21260.4
5	Type of Colony and use (in %)	Road	25%	2,53	10216.
	Type of colony and ase (m/s)	Commercial	4%	0.44	1795.1
		Industrial	12%	1.19	4819.9
		Builtup	23%	2,29	9269.2
6	Name of Revenue Estate		Safid	on	L
7	District Name		Jind		
8	Name of Controlled Area	Safidon			
3	Urban Area		Safidon		
10	Year of establishment		2011		
11	Total No. of Plots	114			
12	No. of Constructed Plots(Residential+Commercial+Industrial)	21+11+27=59			
13	Number of vacant plots	55			
14	Number of families residing in the colony		21		
15	Does the colony have street light?	No			
16	Does the colony have Electric Line	Yes			
17	Does the colony have HT Line	No			
18	Does the colony have water supply through pipelines?	No			
19	Does the colony have underground sewerage facility?	No			
20	Does the colony have Park or Open space	No			
21	Road type on Colony (Kuccha/Pucca)		Kuccha/Pucca		
22	Different roads (in meters)	Road Width)
	Pucca Road	5 M to 8 M		520.19 M	
	Kuccha Road	4 M to 8 M 1536.69 M			
23	Minimun Road Width	4 M			
24	Area of the community site(in acres)	No			
25	Is the RWA registered	No			
26	Additional Information, if any	No			
27	Name of Electric Substation	DHBVN			


DRG. NO D.T.P. (J) DT. LAYOUT PLAN CHECKED AND VERIFIED AT SITE BY: JUNIOR ENGINEER: LON JUNIOR DRAFTSMAN: DISTRICT TOWN PLANNER:


SENIOR TOWN PLANNER:

OFFICE OF DISTRICT TOWN PLANNER, JIND TOWN & COUNTRY PLANNING DEPTT, HARYANA

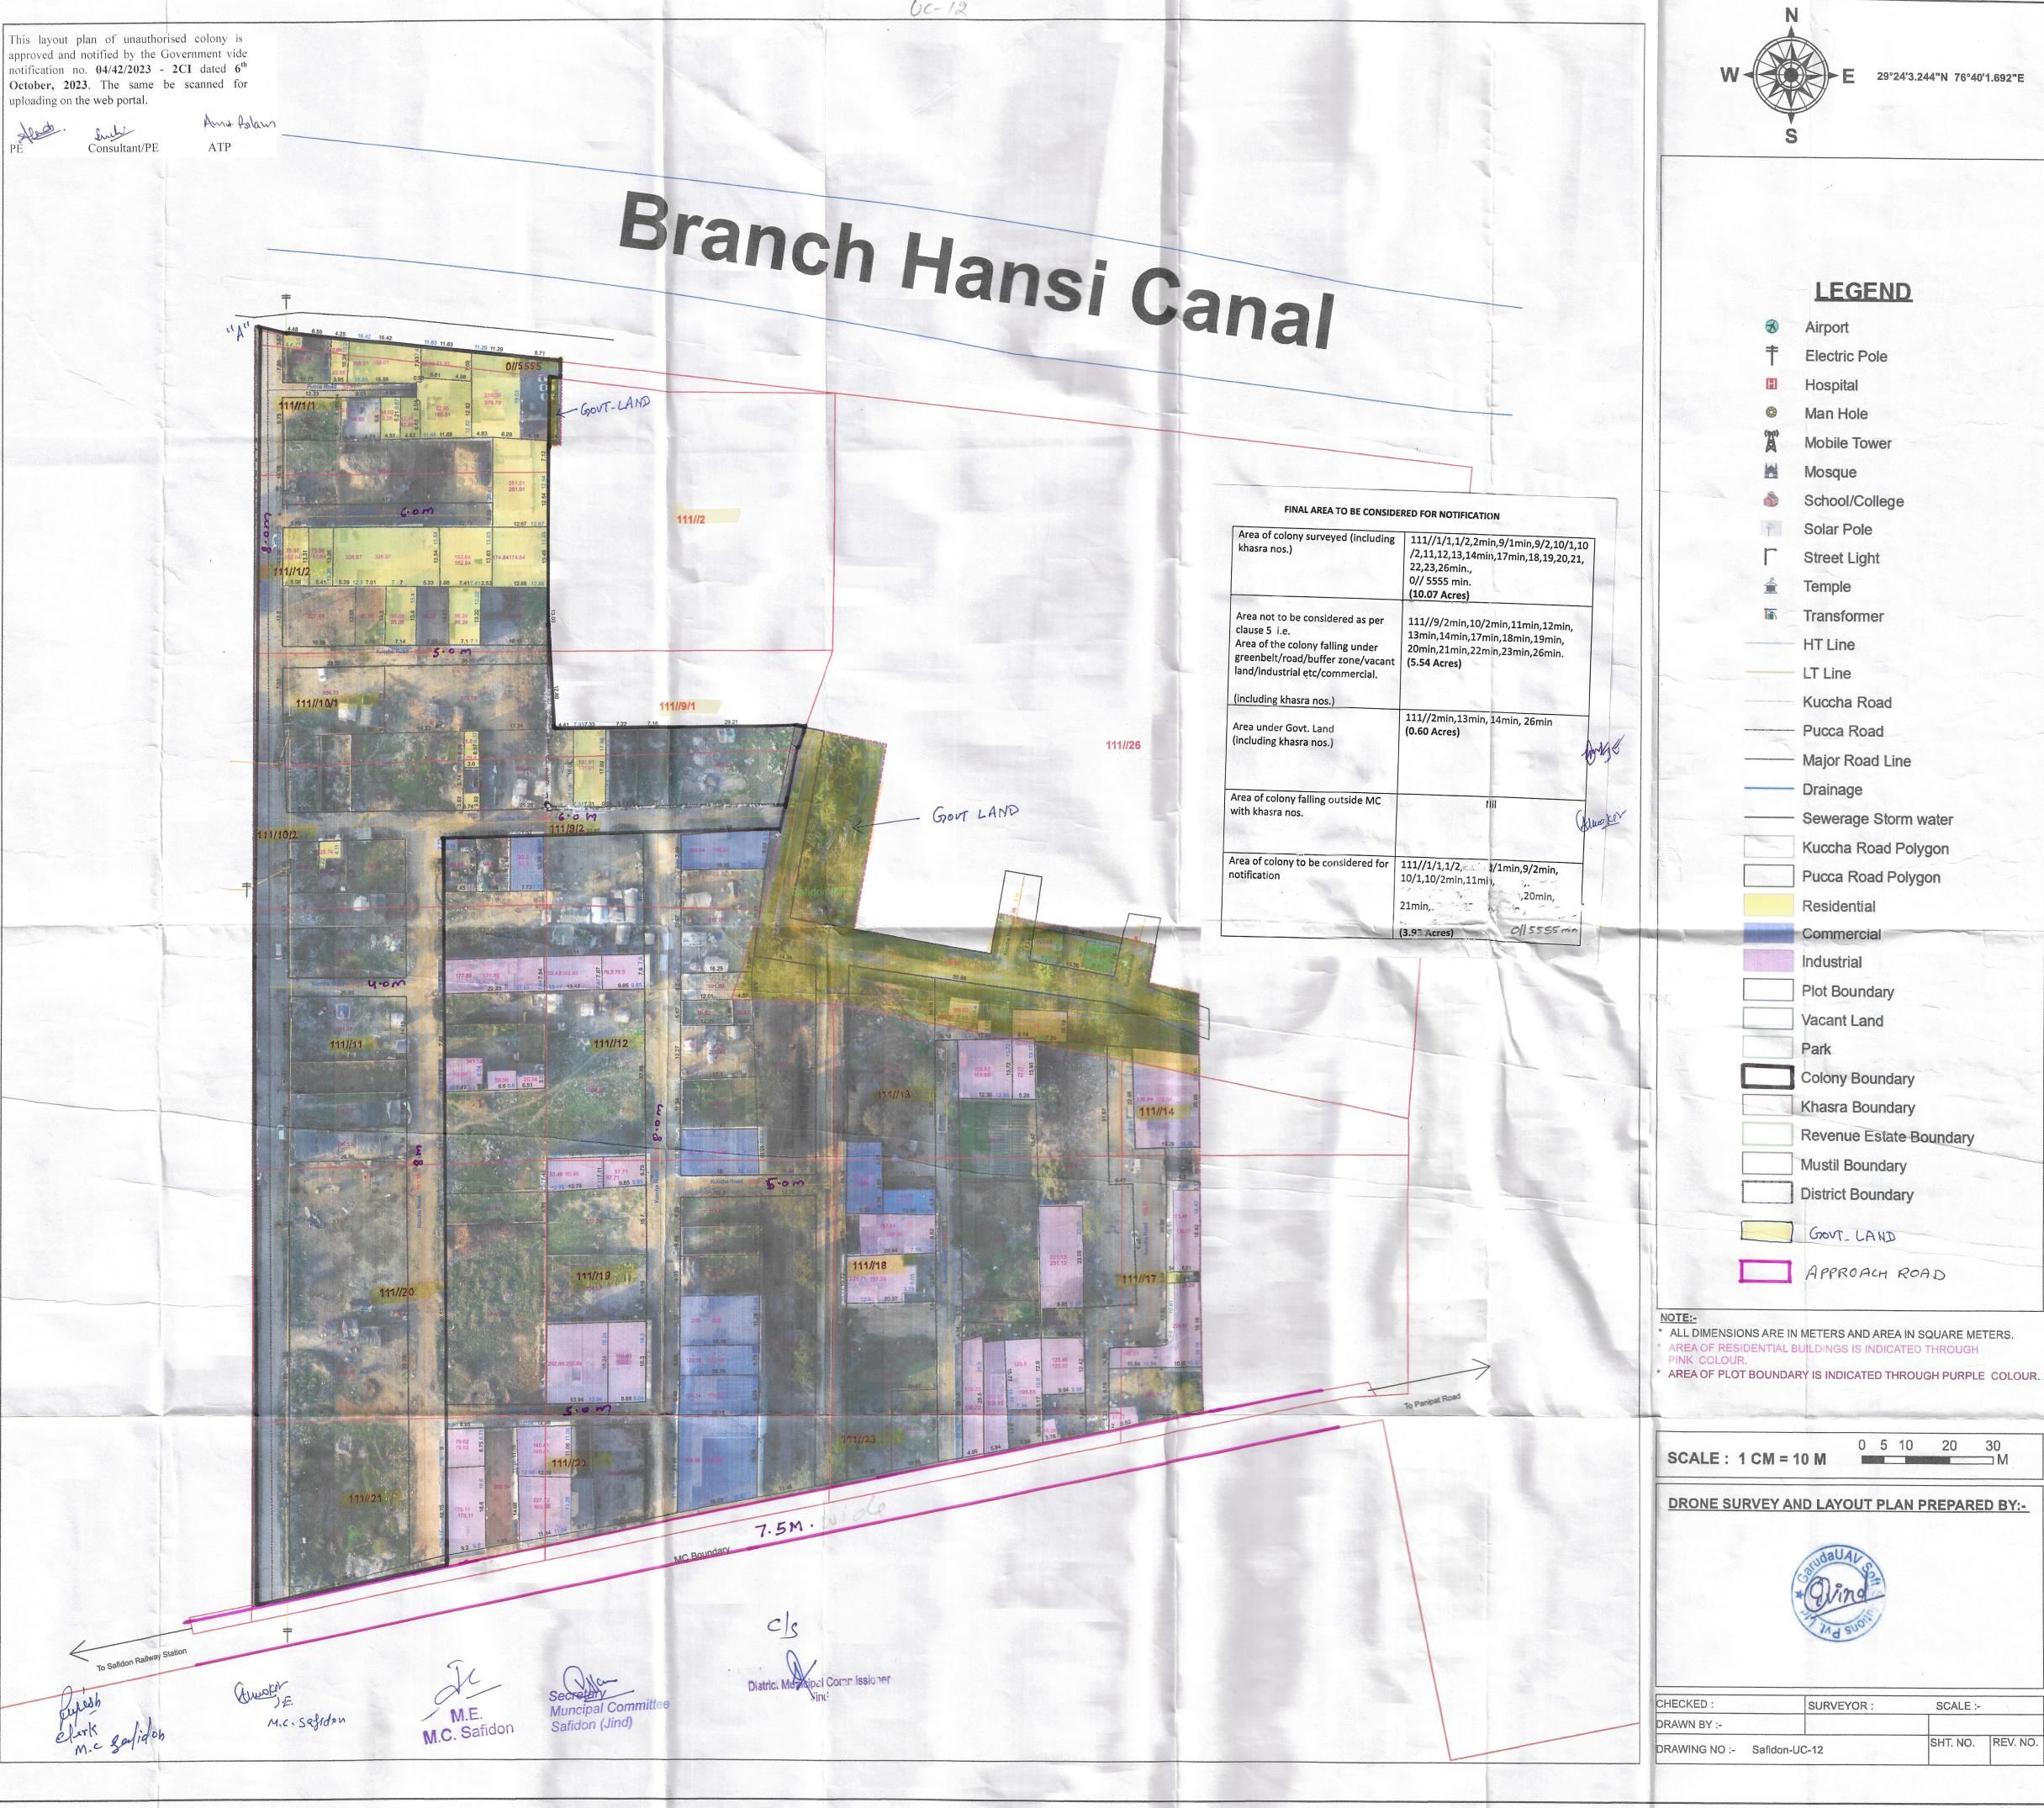



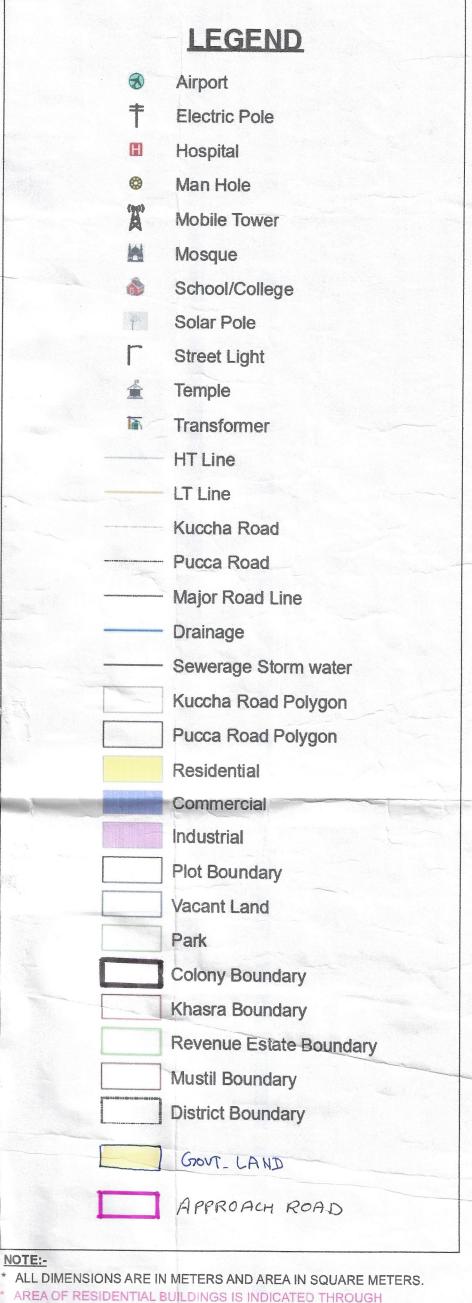

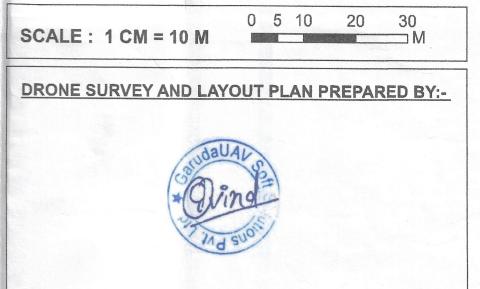

CHECKED:	SURVEYOR:	SCALE :-	
DRAWN BY :-			
DRAWING NO :- Safidon-	UC-12	SHT. NO.	REV. NO