



DISTRICT FARIDABAD

LAYOUT PLAN OF UNNAMED COLONY ID-6794_2, IN THE REVENUE ESTATE OF VILLAGE FARIDPUR, SUB-THEHSIL-TIGAON, DISTRICT - FARIDABAD, COMPRISING IN KHASRA NOS. POCKET 1: PANCHAYAT COLONY KHASRA NO: 19//9, 12 POCKET 2: KHASRA NO. 9//11, 12MIN, 19MIN, 20, 21MIN, 22MIN, 23MIN

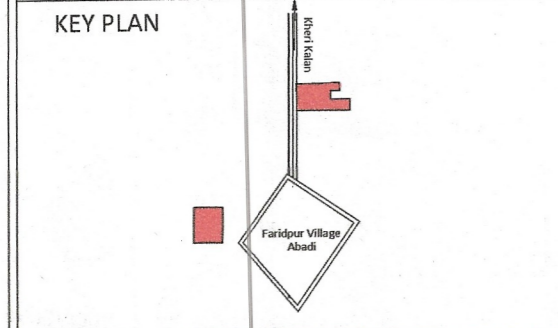

DETAILS OF UNAUTHORIZED COLONY	
Sr. No.	Description
1	Colony name: UNNAMED COLONY ID-6794_2
2	Area: POCKET 1: PANCHAYAT COLONY 3.5 ACRES POCKET 2: 4.62 ACRES
3	Location of the colony: (i) Within MC: Yes (ii) Outside MC: No
4	Type of Colony and use (%): NA
5	Controlled Area: Controlled Area Around Old Faridabad East of Agra Canal Part-II
6	Urban Area: FARIDABAD
7	Year of establishment: NA
8	Layout Plan (Scale): 1:1000
9	Total Plots: NA
10	Constructed Plots: NA
11	Number of vacant plots: NA
12	Number of families residing in the colony: NA
13	Does the colony have street light?: NA
14	Does the colony have water supply through pipelines?: NA
15	Does the colony have underground sewerage facility?: NA
16	If connected to any external Sewage treatment plant? (Y/N): NA
17	Does the colony have Park or Open space: NA
18	Road type on Colony (kacha/pucca): NA
19	Width of Approach road (in meters): 6.0
20	Width of Different roads (in meters): 3.5, 4.5, 6.0
21	Minimum Road width: 3.5
22	Electricity provided to households through which sub station: Kheri Kalan
23	Does the colony have community site: No
24	Area of the community site (in acres): Nil
25	Is the RWA registered: NA
26	Additional Information, if any: Partially Notice issued

Note: Panchayat colony and extension of Village Abadi in violation of Controlled Areas Act. May be omitted as unauthorized colony from Geo-Portal

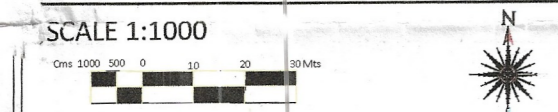

DRONE SURVEY AND LAYOUT PLAN PREPARED BY:- PD CONSULTING ENGINEERS PVT.LTD
PDCE GROUP
 hello@pdcegroup.com
 Red House, Behind MCD School, Mehrauli-Gurgaon Rd, Ghitorni, Delhi - 30

Checked: PDCE Surveyor: RISHI PAL Sheet: A0
 Drawn By: NAYAB Sit. No.: 1 OF 1 ID-6794_2

NOTE: ALL DIMENSIONS ARE IN METERS AND AREA IN ACRES.
 DRG. NO. DTP(E)-FBD/2022/ DATED

LAYOUT PLAN CHECKED AND VERIFIED AT SITE BY:- PATWARI


JUNIOR ENGG.
 ASSISTANT TOWN PLANNER
 DISTRICT TOWN PLANNER (E)
 SENIOR TOWN PLANNER
 OFFICE-DISTRICT TOWN PLANNER(ENF), FARIDABAD TOWN & COUNTRY PLANNING DEPTT., HARYANA

Total Area
1070.45
0.462
Acres

Total Area - Pocket - 2
4.62 acres
Built up Area = 1.57 Acres
Area under roads = 33.98
0.462 acres
Vacant Area = 2.888
(33.36)

Road Length
0 to 3m - Nil
3m to 6m = 211.3m
6m - 9m = 161.86m

PANCHAYAT COLONY
Panchayat Colony

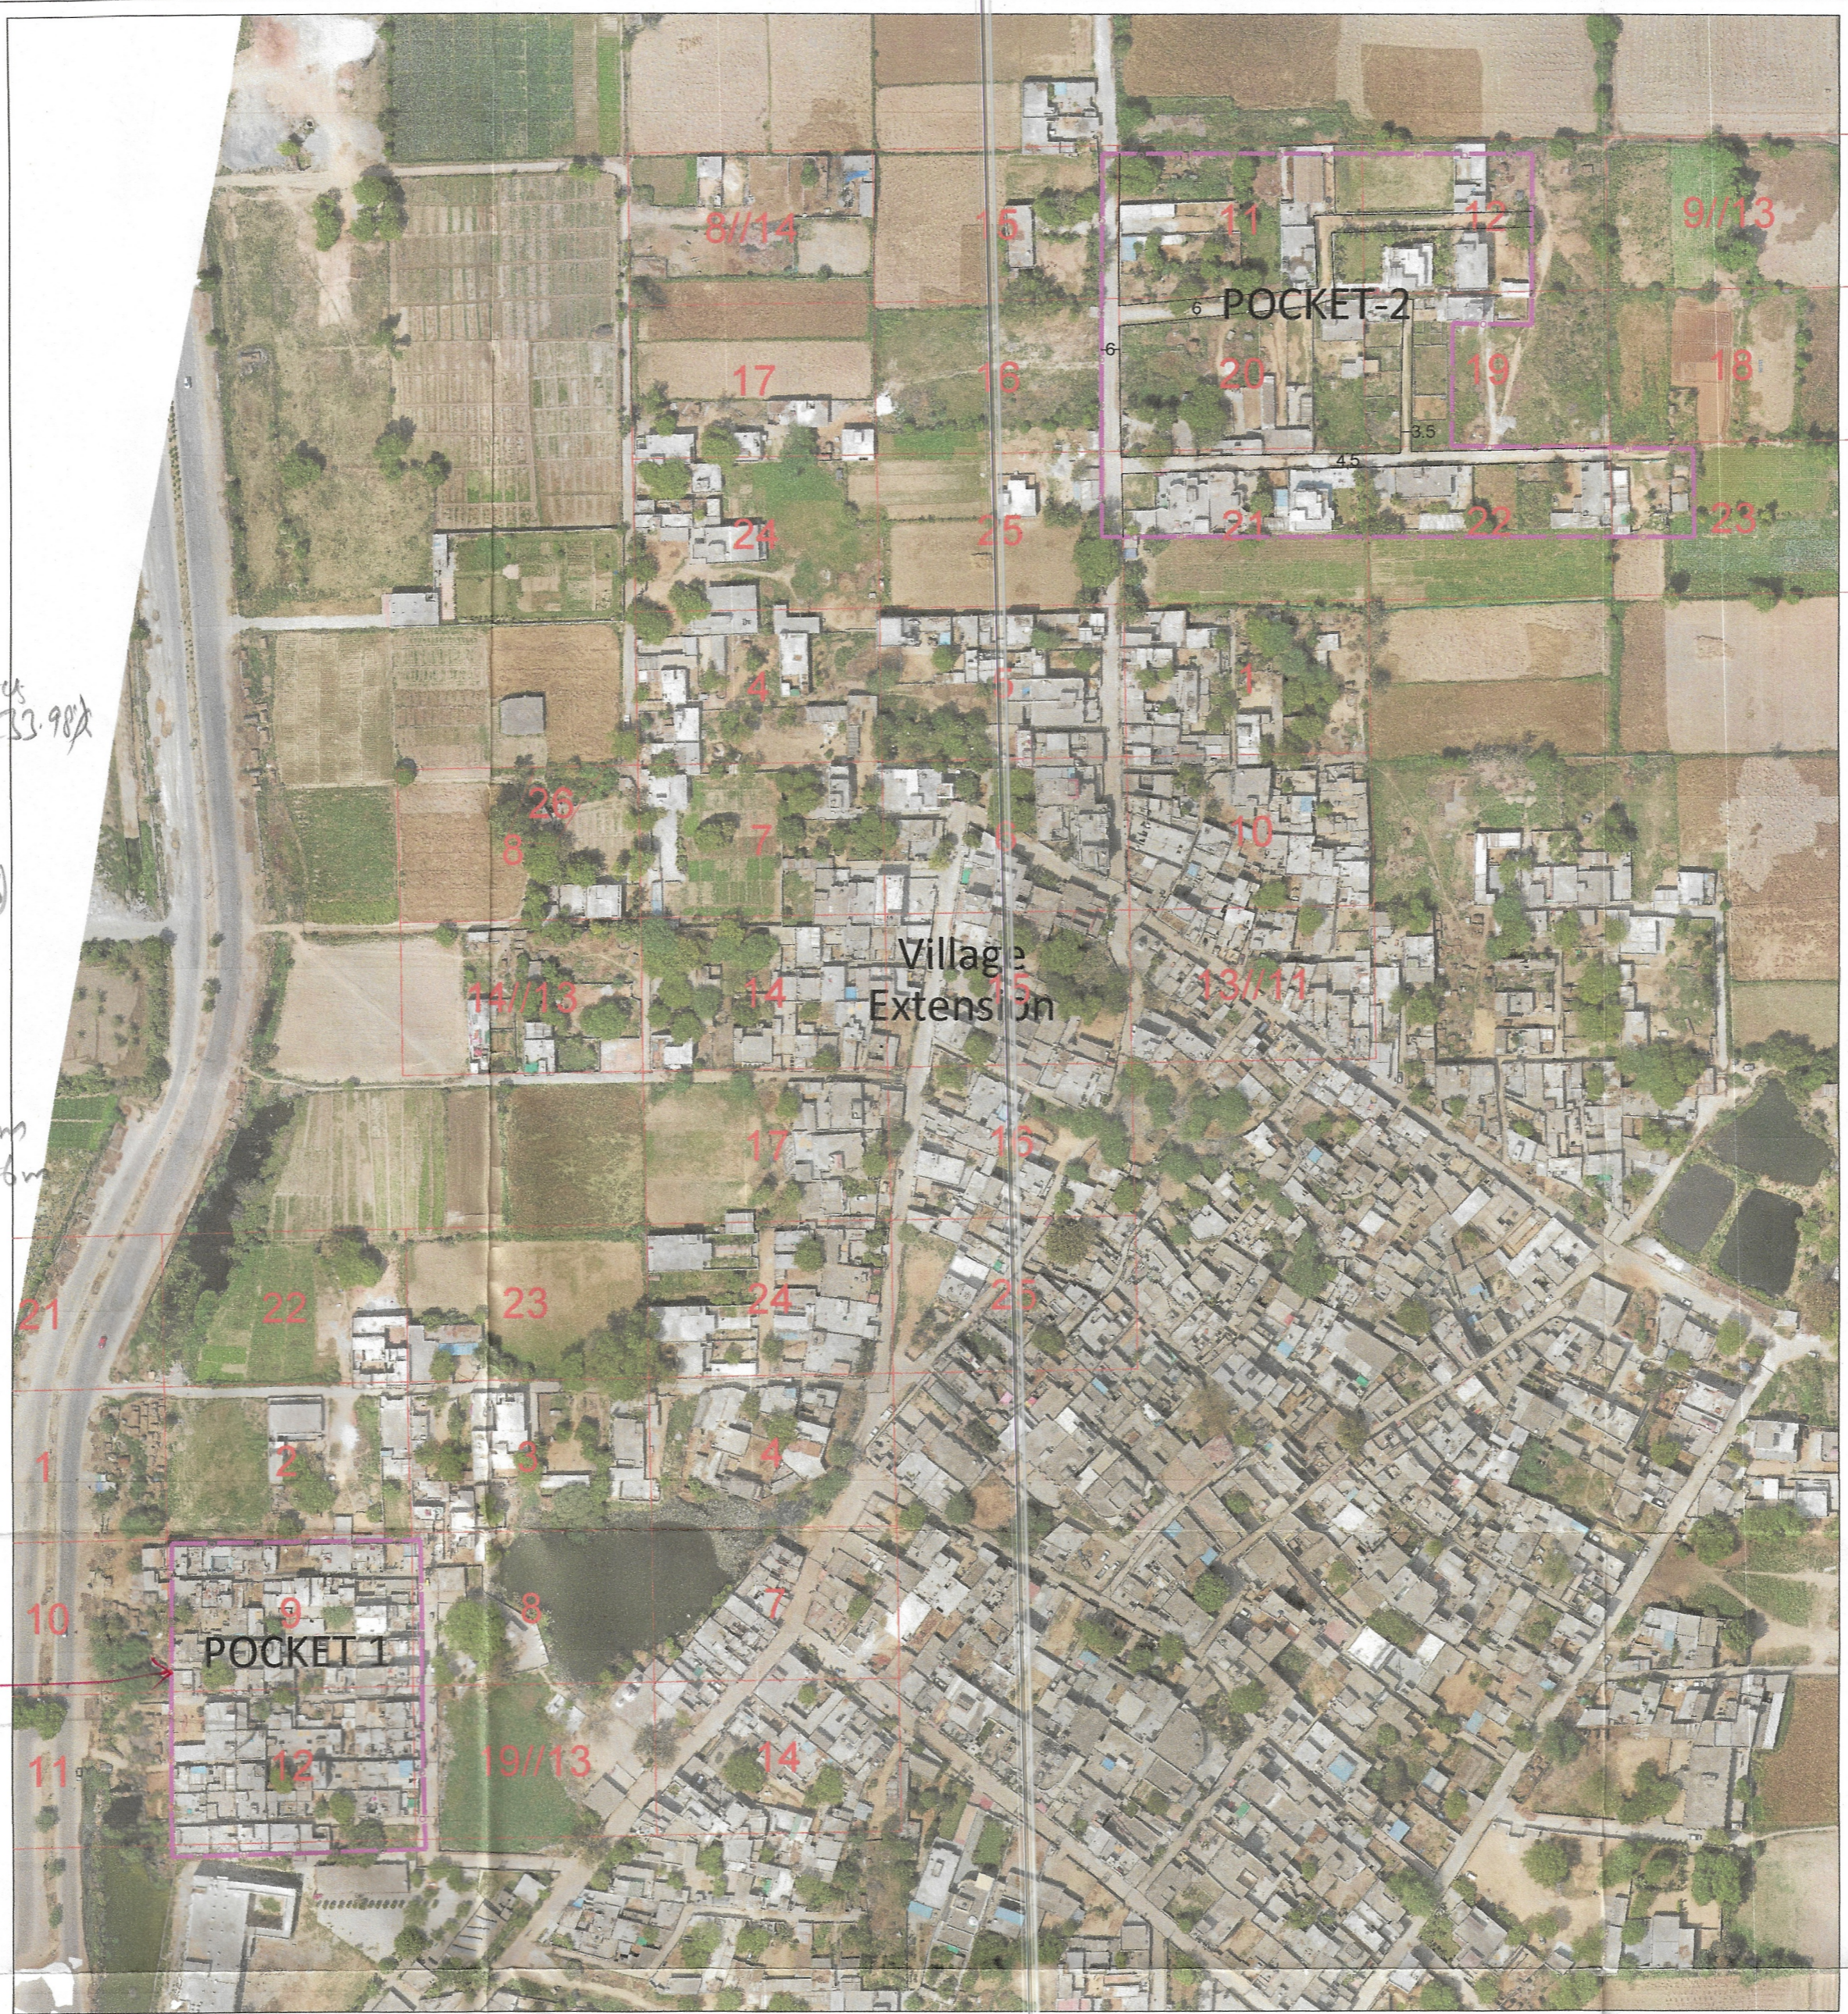

NOTE:
 POCKET 1: PANCHAYAT COLONY KHASRA NO: 19//9, 12
 POCKET 2: KHASRA NO.9// 11, 12MIN, 19MIN, 20, 21MIN, 22MIN, 23MIN

[Signatures]
 PATWARI KANUGO SR. ARCH.
 D.M J.E DTP
 CTP CMC DIV.CMC

This layout plan of unauthorised colony is approved and notified by the Government vide notification no. 04/42/2023 - 2CI dated 25th July, 2023. The same be scanned for uploading on the web portal.

[Signatures]
 Consultant/PE ATP

LEGEND																															
Manhole/ Chamber	<table border="0"> <tr> <td>Murraba Line</td> <td>Commercial Area</td> <td>Industrial Area</td> </tr> <tr> <td>TF/Electric/Mobile tower</td> <td>Built Up Area/Residential</td> <td>Vacant Plot (Not to be Regularised)</td> </tr> <tr> <td>Street Light/Solar pole</td> <td>Colony Boundary</td> <td>Public & Semipublic Area</td> </tr> <tr> <td>Revenue Boundary</td> <td>HT Line</td> <td></td> </tr> <tr> <td>City Road</td> <td>Sewerage Line</td> <td></td> </tr> <tr> <td></td> <td>Water Supply Line</td> <td></td> </tr> <tr> <td></td> <td>Vacant Land/Plot</td> <td></td> </tr> <tr> <td></td> <td>Drain/Culvert / Bridge</td> <td></td> </tr> <tr> <td></td> <td>Kaccha Road</td> <td></td> </tr> <tr> <td></td> <td>Pacca Road</td> <td></td> </tr> </table>	Murraba Line	Commercial Area	Industrial Area	TF/Electric/Mobile tower	Built Up Area/Residential	Vacant Plot (Not to be Regularised)	Street Light/Solar pole	Colony Boundary	Public & Semipublic Area	Revenue Boundary	HT Line		City Road	Sewerage Line			Water Supply Line			Vacant Land/Plot			Drain/Culvert / Bridge			Kaccha Road			Pacca Road	
Murraba Line	Commercial Area	Industrial Area																													
TF/Electric/Mobile tower	Built Up Area/Residential	Vacant Plot (Not to be Regularised)																													
Street Light/Solar pole	Colony Boundary	Public & Semipublic Area																													
Revenue Boundary	HT Line																														
City Road	Sewerage Line																														
	Water Supply Line																														
	Vacant Land/Plot																														
	Drain/Culvert / Bridge																														
	Kaccha Road																														
	Pacca Road																														
Divider Road	Temple/Mosque/Church/Flag Post																														
	Statue/School/Airport/Hospital/Well																														
	Tin Shed																														