


**DISTRICT FARIDABAD**

LAYOUT PLAN OF UNNAMED COLONY ID-4909\_1 IN THE REVENUE ESTATE OF VILLAGE -BARAULI, TEHSIL-FARIDABAD, DISTRICT- FARIDABAD COMPRISING IN KHASRA NO. 15//11,20min, 16//15min,16min,17min,24min,25min  
*Baroli Pur Majra Baroli - 13//11 min*  
 KEY PLAN

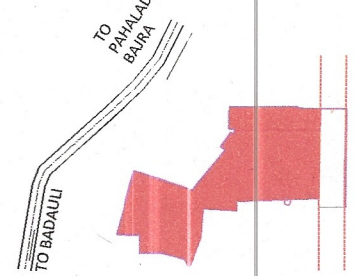

NOTE:- AREA PROPOSED FOR NOTIFICATION IS NOT COVERED UNDER NCZ.


BALANCE AREA = 2.168 ACRE  
 BEARING KHASRA NO. 15//11,20 MIN,16//15 MIN, 16 MIN, 17 MIN,24 MIN, 25 MIN  
 TOTAL BUILT UP AREA OF = 1.81 ACRE i.e = 100 %  
 WIDTH OF APPROACH ROAD 8 M WIDE VILLAGE LINK ROAD

*Handwritten signature*

*Correction verified*  
*Pointfu*

Sr. No.	Parameter Name	Description
1	Colony name	UNNAMED COLONY PART I (ID-4909_1)
2	Area	2.168 Acres
3	Location of the colony	Near Barauli Village Abadi
	(i) Within MC	Yes
	(ii) Outside MC	No
4	Type of Colony and built up (%)	Residential 100%
5	Controlled Area	CONTROLLED AREA AROUND OLD FARIDABAD EAST OF AGRA CANAL PART I
6	Urban Area	FARIDABAD
7	Year of establishment	2010
8	Layout Plan (Scale)	1:1000
9	Total Plots	NA
10	BUILT UP AREA	100 %
11	VACANT AREA	NIL
12	Number of families residing in the colony	NA
13	Does the colony have street light?	No
14	Does the colony have water supply through pipelines?	No
15	Does the colony have underground sewerage facility?	No
16	If connected to any external Sewage treatment plant? (Y/N)	No
17	Does the colony have Park or Open space	NA
18	Road type on Colony (Kacha/Pucca)	NA
19	Width Of Different roads (in meters)	Road Width: 3.0M, Length (in mtrs): 63.90 3.50M, 109.09
20	Minimum Road width	3.0M
21	Electricity provided to households through which sub station	NA
22	Does the colony have community site	No
23	Area of the community site(in acres)	NIL
24	Is the RWA registered	NA
25	Additional information, if any	

NOTICE NOT ISSUED AS BEEN EXTENSION OF VILLAGE ABADI. MAY BE REMOVED FROM GEOPORTAL AS UNAUTHORIZED COLONY

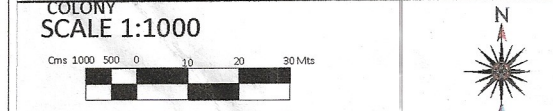

DRONE SURVEY AND LAYOUT PLAN PREPARED BY:- PD CONSULTING ENGINEERS PVT.LTD


**PDCE GROUP**  
 TRANSFORMING QUALITY & SERVICE  
 hello@pdcegroup.com  
 www.pdcegroup.com  
 Red House, Behind MCD School, Mehrauli-Gurgaon Rd, Ghitorni, Delhi - 30

Checked: PDCE Surveyor: RISHI PAL Sheet: A1  
 Drawn By: NAYAB Sht. No.: 1 OF 1 ID-4909\_1

ALL DIMENSIONS ARE IN METERS AND AREA IN ACRES.  
 DRG. NO. DTP(E)-FBD/2022/ DATED

LAYOUT PLAN CHECKED AND VERIFIED AT SITE BY:- PATWARI

JUNIOR ENGG/PA. *[Signature]*  
 ASSISTANT TOWN PLANNER *[Signature]*  
 DISTRICT TOWN PLANNER *[Signature]*  
 SENIOR TOWN PLANNER  
 OFFICE-DISTRICT TOWN PLANNER(ENF), FARIDABAD TOWN & COUNTRY PLANNING DEPTT., HARYANA

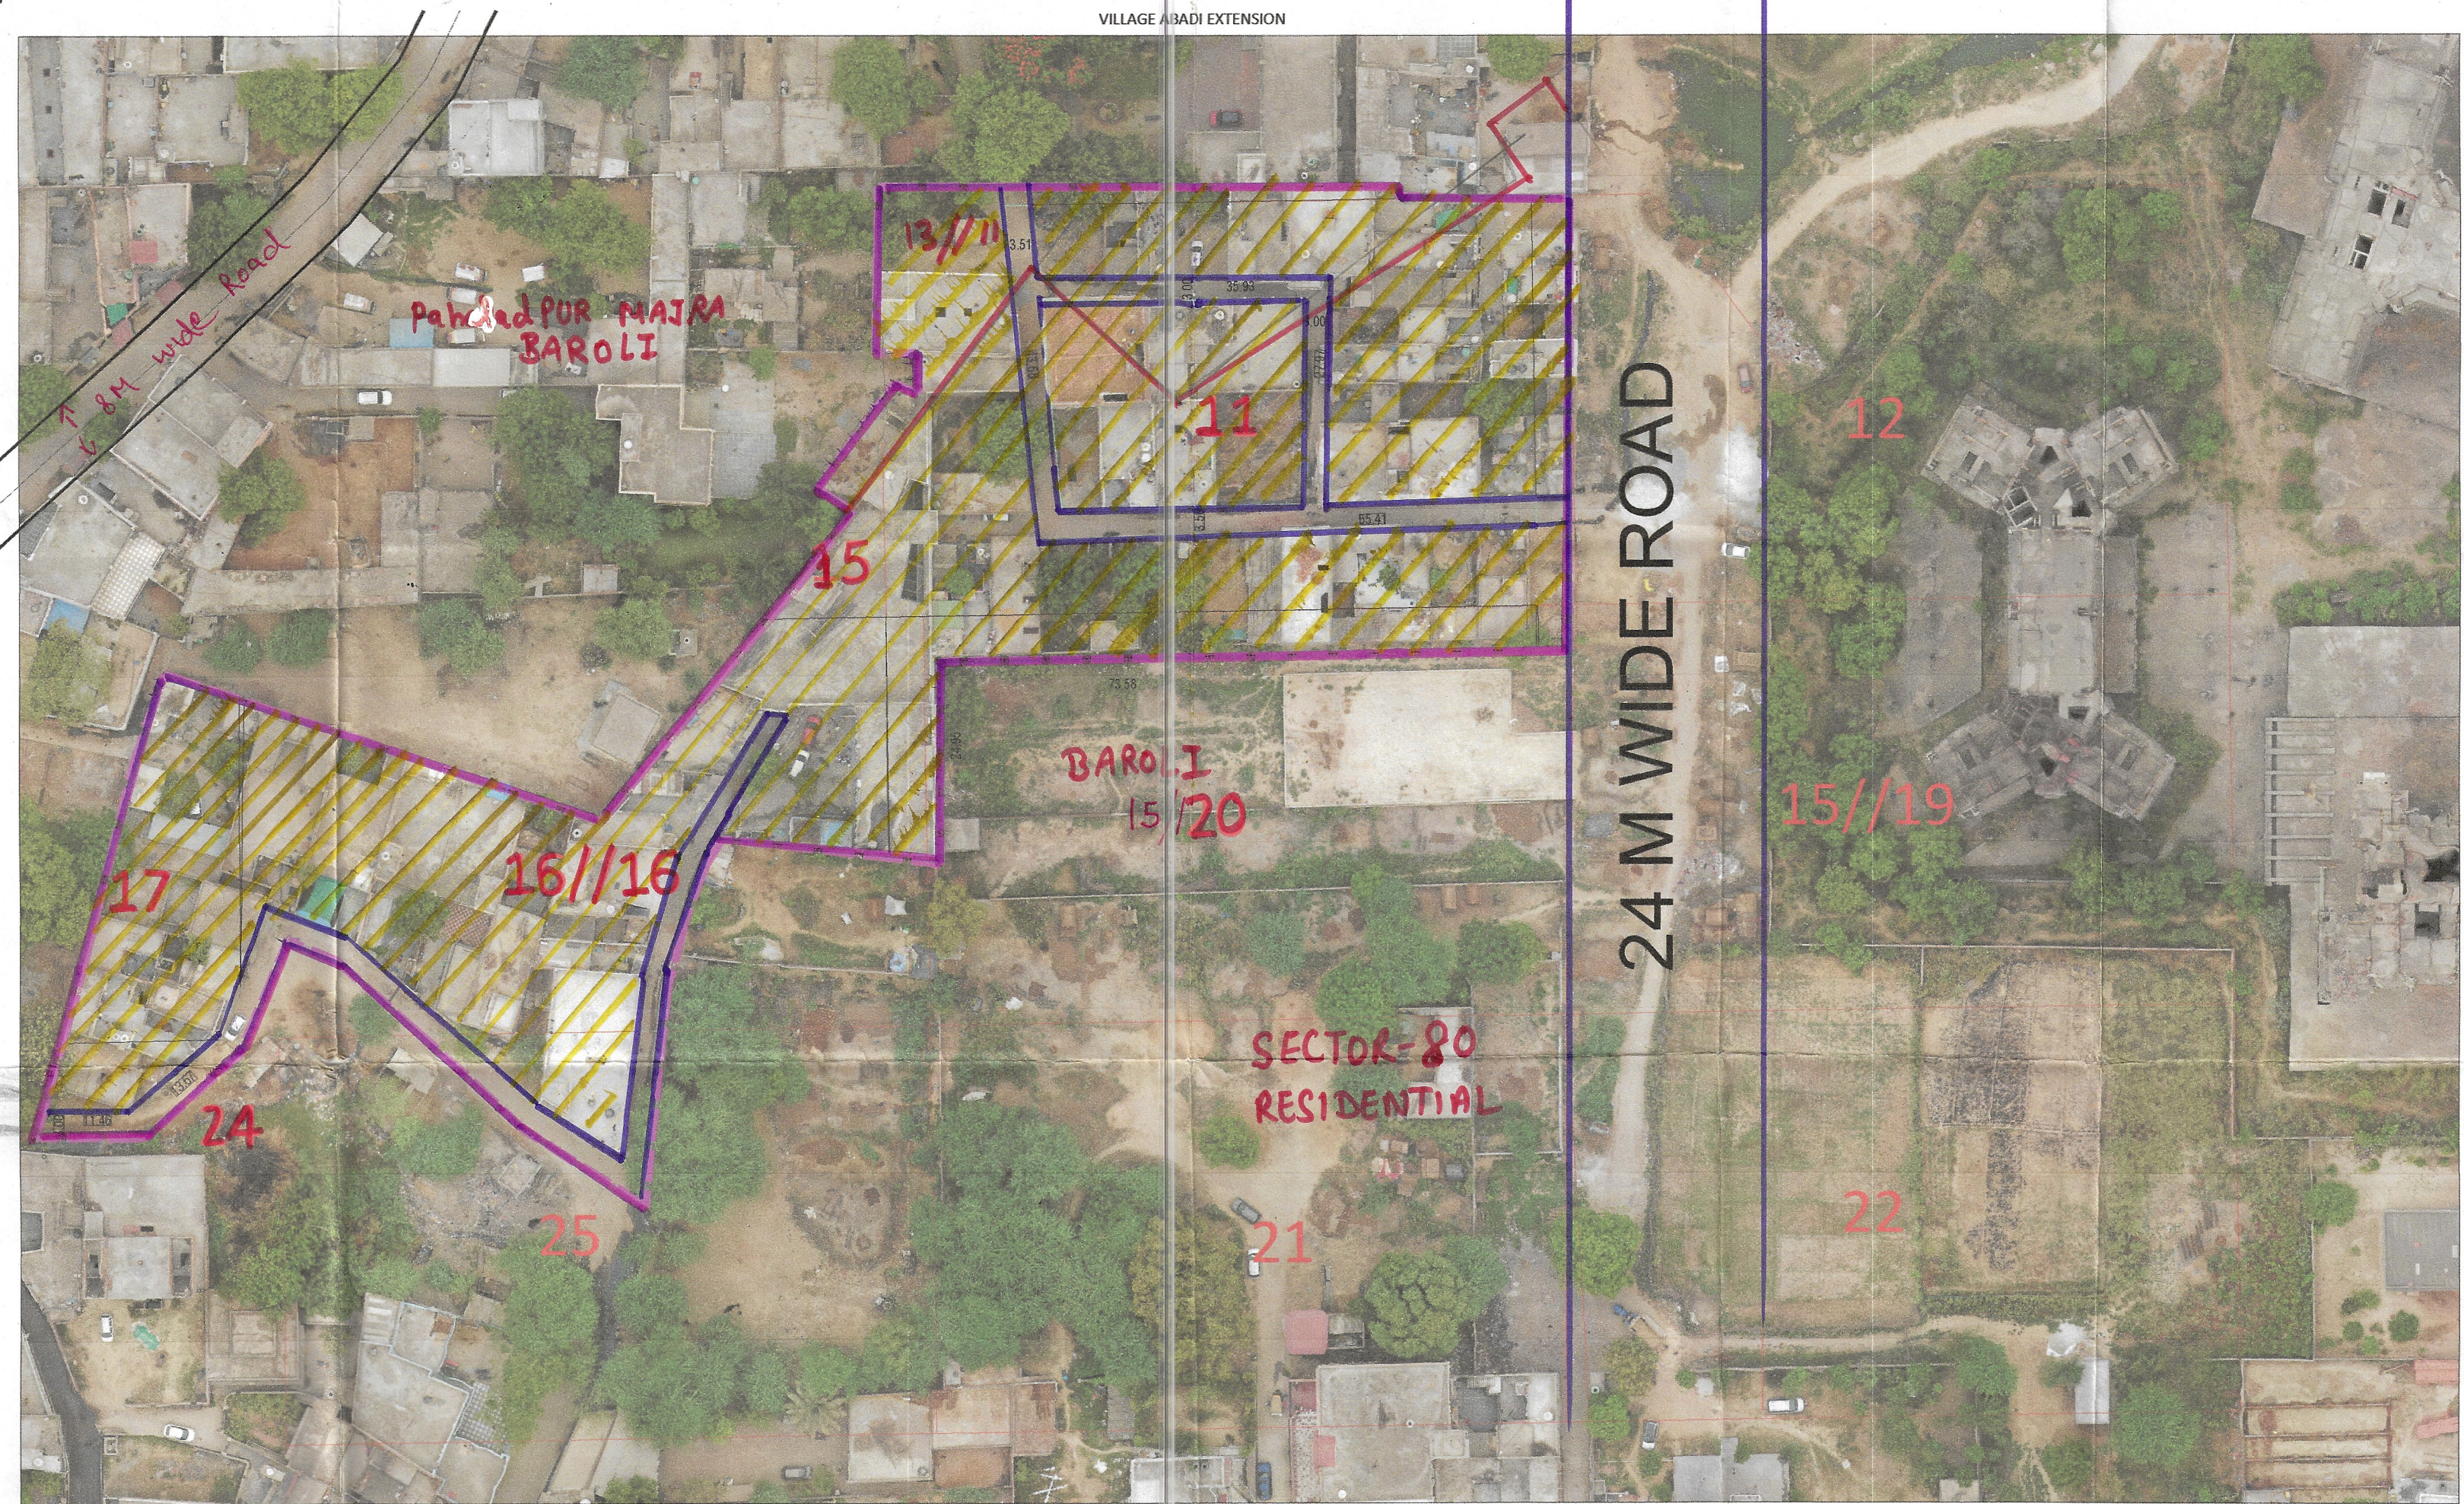

This layout plan of unauthorised colony is approved and notified by the Government vide notification no. 09/12/2023 - 4CII dated 15<sup>th</sup> December, 2023. The same be scanned for uploading on the web portal.  
 PE: *[Signature]* Consultant/PE  
 ATP: *[Signature]* ATP

PATWARI *[Signature]* KANUGO *[Signature]* SR. ARCH. *[Signature]* D.M. *[Signature]* J.E. *[Signature]* DTP *[Signature]* CTP *[Signature]* CMC *[Signature]* DIV. COMMISSIONER *[Signature]*

LEGEND		Commercial Area		Industrial Area	
Manhole/ Chamber		Murraba Line		Industrial Area	
TF/Electric/Mobile tower		Khasra Line		Vacant Plot (Not to be Regularised)	
Street Light/Solar pole		Colony Boundary		Public & Semipublic Area	
Revenue Boundary		HT Line		Tin Shed	
City Road		Sewerage Line			
		Water Supply Line			
		Commercial Area			
		Built Up Area/Residential			
		Vacant Land/Plot			
		Drain/Culvert / Bridge			
		Kaccha Road			
		Pacca Road			
		Divider Road			
		Temple/Mosque/Church/Flag Post			
		Statue/School/Airport/Hospital/Well			