


DISTRICT FARIDABAD


LAYOUT PLAN OF UNNAMED COLONY ID-6794_3 IN THE REVENUE ESTATE OF VILLAGE FARIDPUR, TEHSIL-TIGAOIN, DISTRICT-FARIDABAD COMPRISING IN KHASRA NO. 20/3min, 5min, 6min, 8min, 12min, 13, 4min, 7min, 9min, 14min, 15min, 16min, 18min, 19min, 20min, 21min, 22min

KEY PLAN

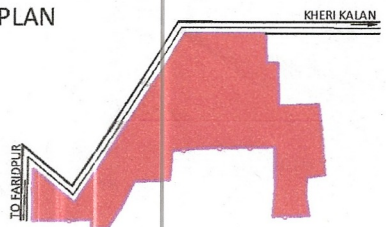

Sr. No.	Parameter Name	Description
1	Colony name	UNNAMED COLONY ID-6794_3
2	Area	10.88 Acres
3	Location of the colony	Near Faridpur Village Abadi
4	(i) Within MC	Yes
	(ii) Outside MC	No
4	Type of Colony and use (in %)	Residential NA Industrial NA
	Controlled Area	CONTROLLED AREA AROUND OLD FARIDABAD EAST OF AGRA CANAL PART II
6	Urban Area	FARIDABAD
7	Year of establishment	NA
8	Layout Plan (Scale)	1:1000
9	Total Plots	NA
10	Constructed Plots (Residential+Industrial)	65/ 3.97 Acre
11	Number of vacant plots	NA
12	Number of families residing in the colony	NA
13	Does the colony have street light?	No
14	Does the colony have water supply through pipelines?	No
14	Does the colony have underground sewerage facility?	No
15	If connected to any external Sewage treatment plant? (Y/N)	No
16	Does the colony have Park or Open space	NA
17	Road type on Colony (kacha/pucca)	NA
18	Width Of Different roads (in meters)	Road Width
		Length (in mtr)
19	Minimum Road width	5.00M
20	Electricity provided to the colonies through which sub station	PALI
21	Does the colony have community site	No
22	Area of the community site (in acres)	Nil
23	Is the RWA registered	NA
24	Additional Information, if any	

NOTICE ISSUED: VILLAGE ABADI EXTENSION: NO URBAN AREA ACT VIOLATION. IT IS CONTROLLED AREA ACT VIOLATION HENCE MAY BE CONSIDERED FOR OMISSION FROM GEOPORTAL AS UNAUTHORIZED COLONY.

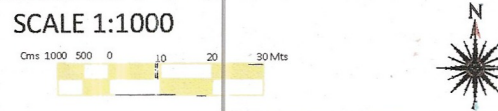

DRONE SURVEY AND LAYOUT PLAN PREPARED BY:- PD CONSULTING ENGINEERS PVT.LTD


hello@pdcegroup.com pdcegroup.com
Red House, Behind MCD School, Mehrauli-Gurgaon Rd, Ghitori, Delhi - 30

Checked : PDCE Surveyor : RISHI PAL Sheet :- A0
Drawn By: NAYAB Sht. No. :- 1 OF 1 ID-4728

NOTE: ALL DIMENSIONS ARE IN METERS AND AREA IN ACRES.
DRG. NO. DTP(E)-FBD DATED

LAYOUT PLAN CHECKED AND VERIFIED AT SITE BY:- PATWARI

JUNIOR ENGG. [Signature]
ASSISTANT TOWN PLANNER [Signature]
DISTRICT TOWN PLANNER [Signature]
SENIOR TOWN PLANNER [Signature]
OFFICE-DISTRICT TOWN PLANNER(ENF), FARIDABAD TOWN & COUNTRY PLANNING DEPTT., HARYANA

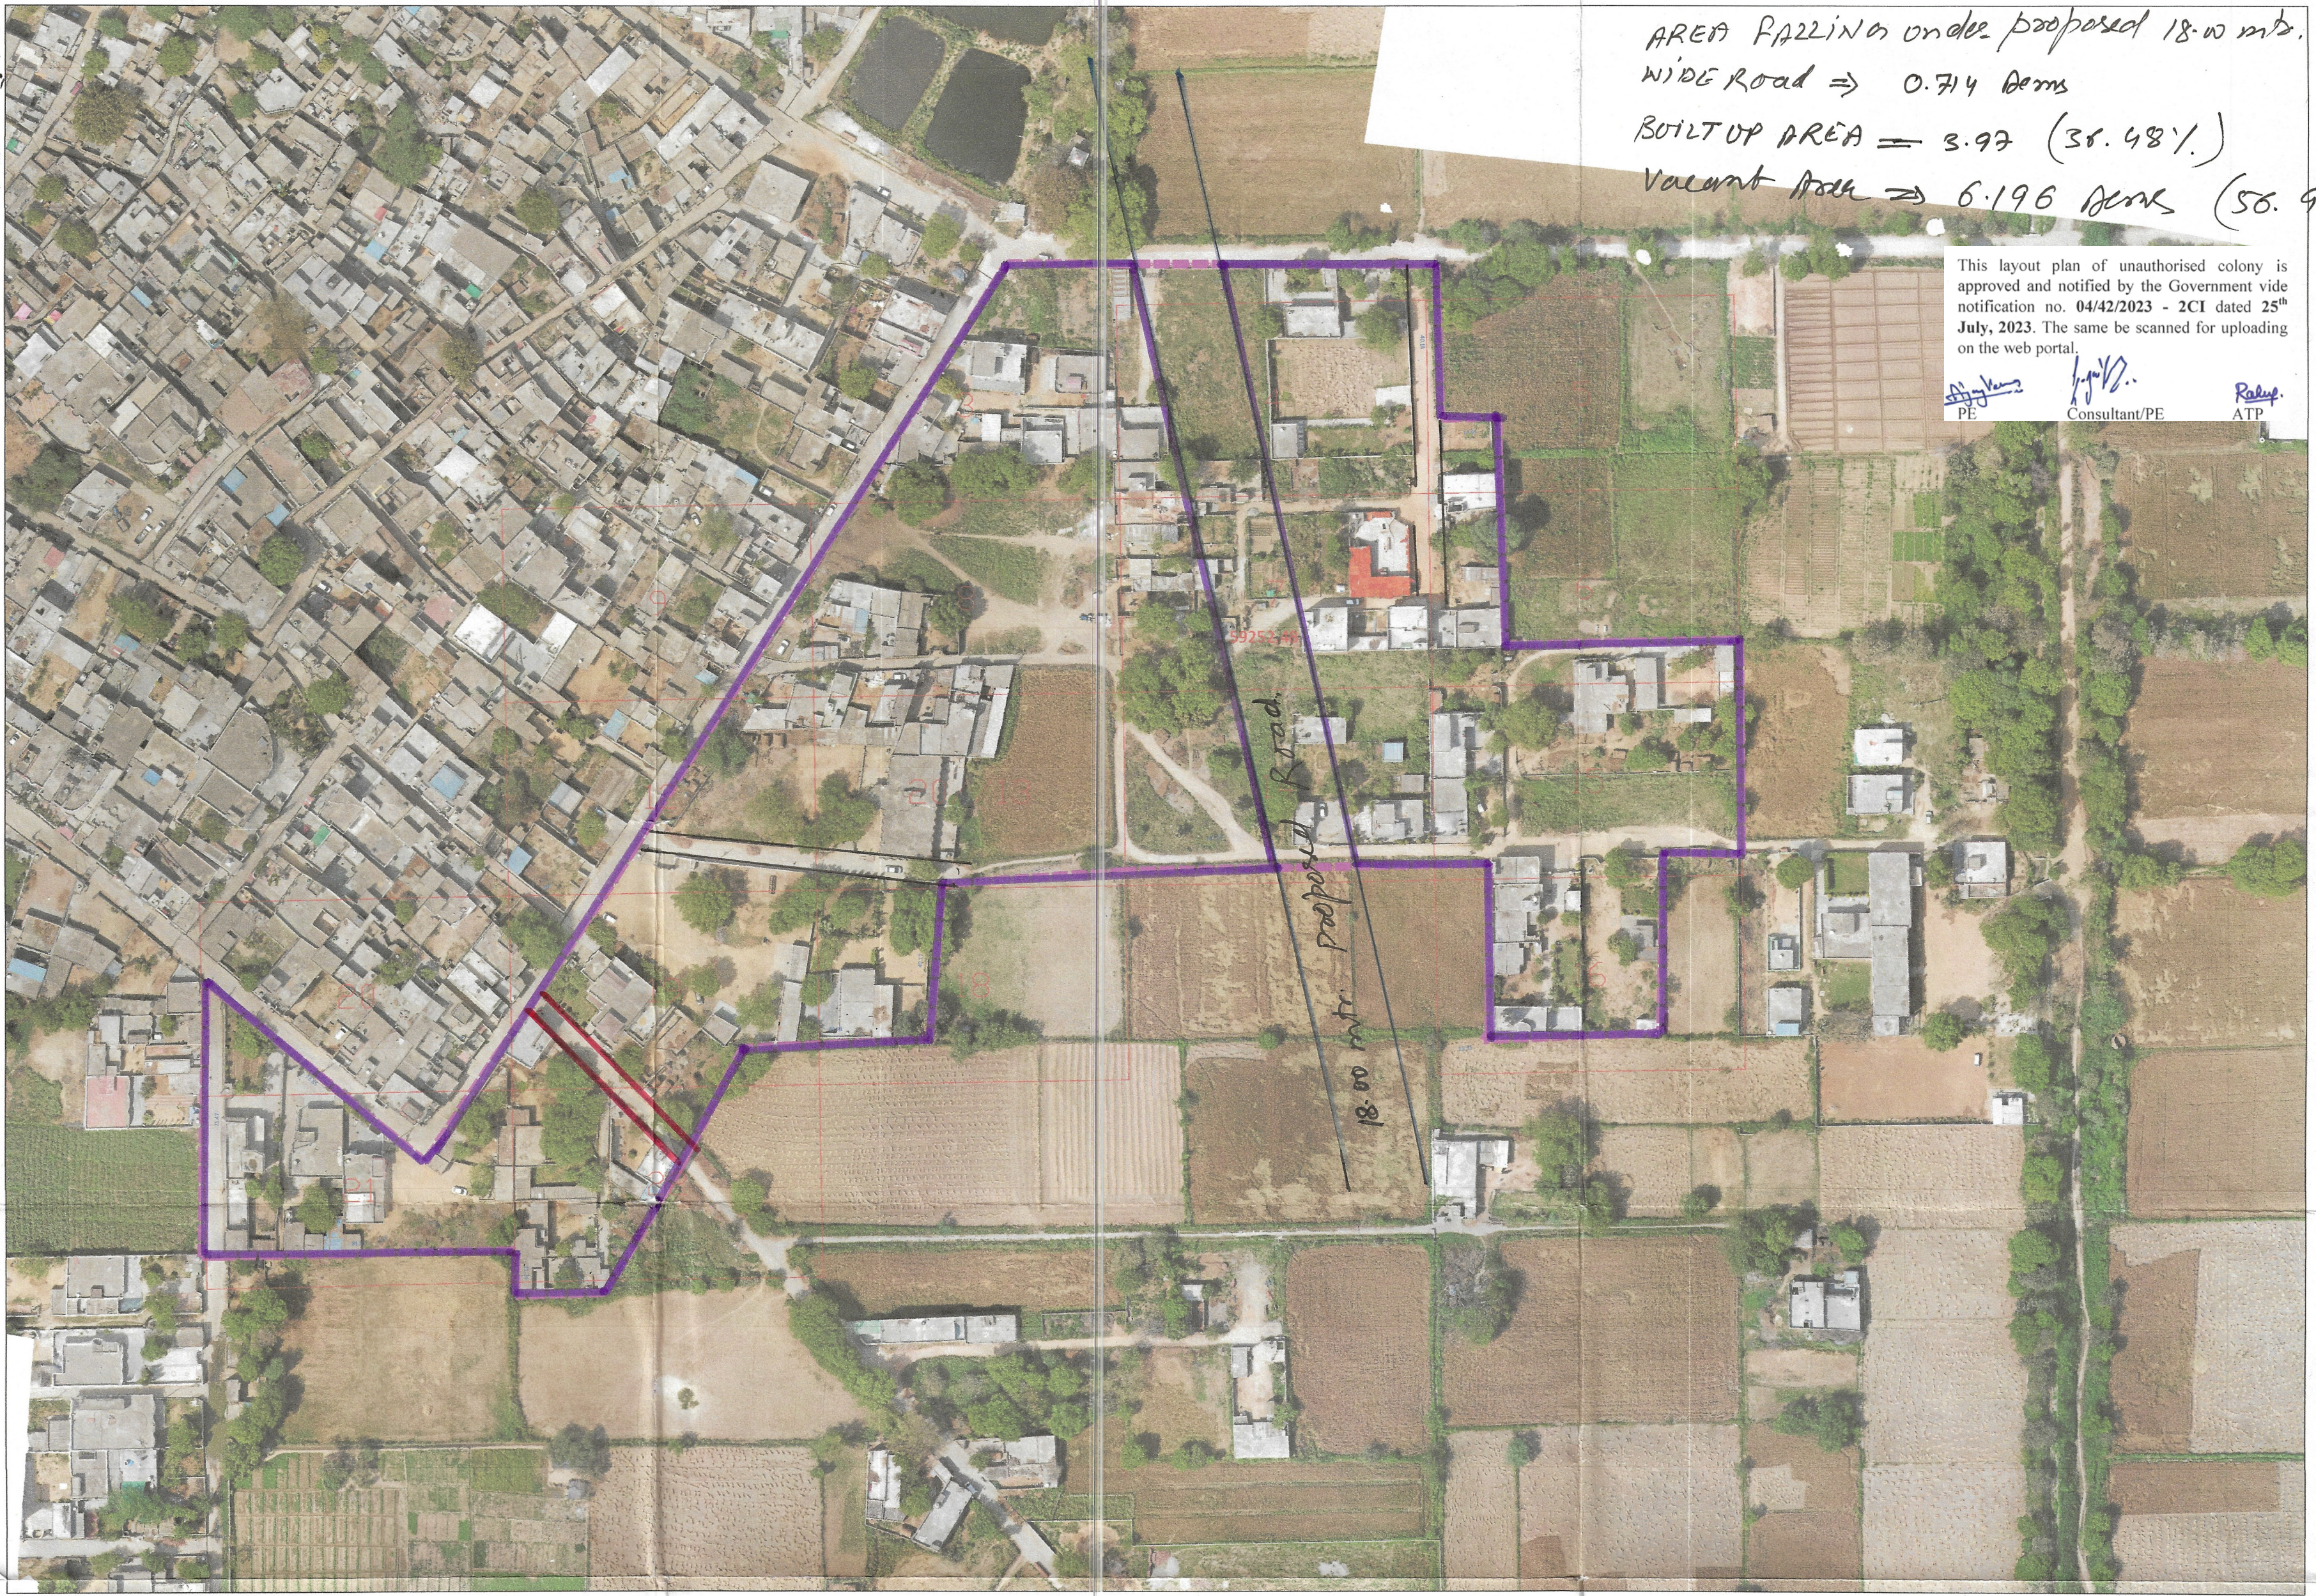

AREA FALLING UNDER PROPOSED 18.00 mtr. WIDE ROAD => 0.714 Acre
BUILT UP AREA = 3.97 (36.48%)
Vacant Area => 6.196 Acre (56.95%)

This layout plan of unauthorised colony is approved and notified by the Government vide notification no. 04/42/2023 - 2CI dated 25th July, 2023. The same be scanned for uploading on the web portal.
[Signatures] PE, Consultant/PE, ATP

35
Correction Needed
Boundary & Area

EXTENDED ABADI OF VILLAGE FARIDPUR

LEGEND	Murraba Line	Commercial Area	Industrial Area
Manhole/ Chamber	Khasra Line	Built Up Area/Residential	Vacant Plot
TF/Electric/Mobile tower	Colony Boundary	Vacant Land/Plot	(Not to be Regularised)
Street Light/Solar pole	HT Line	Drain/Culvert / Bridge	Public & Semipublic Area
Revenue Boundary	Sewerage Line	Kaccha Road	Pacca Road
City Road	Water Supply Line		

[Signatures]
PATWARI KANUGO SR. ARCH.
D.M. J.E. DTP
CTP CMC DIV.CMC