


DISTRICT SIRSA

LAYOUT PLAN OF UNAUTHORIZED COLONY
NEAR KALANWALI POLICE STATION
IN THE REVENUE ESTATE OF VILL KALANWALI
TEH. KALANWALI, DIST. SIRSA

KHASRA NO
1001 min, 1002 min, 1004 min, 1005 min, 1006 min, 1007 min, 1008 min, 1009 min, 1010 min, 1014 min, 1022 min, 1023 min, 1024 min, 1025 min, 1026 min, 2137-2145, 2204 min, 2205, 2206 min, 2210, 2211, 2215 min, 2224, 2225, 2226 min, 2235, 2236, 2237 min, 2240 - 2315, 2469 - 2529, 2565-2568
158 // 18 min, 23 min
159 // 15 min

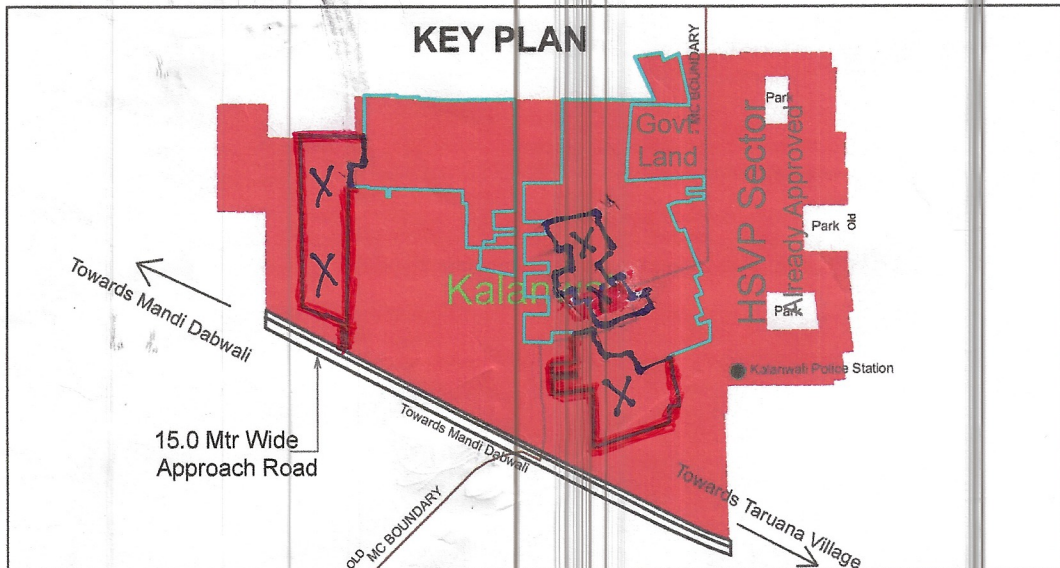


DETAILS OF UNAUTHORIZED COLONY		
Sr. No.	Parameter Name	Description
1	Colony name	UC-K-01
2	Area	25.08 Acres / 10149.15 Sq/M
3	Location of the colony	Near Police Station
4	Municipal Limits Boundary (MC STATUS):	(i) Within MC No (ii) Outside MC No (iii) Partial MC No
5	Type of Colony and use (in %)	Residential Vacant + Open Road Commercial Semi-Public Industrial Builtup
6	Name of Revenue Estate	Kalanwali
7	District Name	Sirsa
8	Name of Controlled Area	MC Kalanwali
9	Urban Area	Kalanwali
10	Year of establishment	2002
11	Total No. of Plots	
12	No. of Constructed Plots (Residential+Commercial+Semi-Public+Industrial)	
13	Number of vacant plots	
14	Number of families residing in the colony	
15	Does the colony have street light?	Yes
16	Does the colony have Electric Line	Yes
17	Does the colony have HT Line	No
18	Does the colony have water supply through pipelines?	Yes
19	Does the colony have underground sewerage facility?	No
20	Does the colony have Park or Open space	Yes
21	Road type on Colony (Kuccha/Pucca)	Kuccha & Pucca
22	Different roads (in meters)	Road Width Length (in mtrs) Pucca Road 3.4 M to 10 M M Kuccha Road 3 M to 10 M M
23	Minimum Road Width	3 M
24	Area of the community site(in acres)	No
25	Is the RWA registered	No
26	Additional information, if any	No
27	Name of Electric Substation	Kalanwali

KHASRA No. -

1001 min, 1002 min, 1004 min, 1005 min, 1006 min, 1007 min, 1008 min, 1009 min, 1010 min, 1014 min, 1022 min, 1023 min, 1024 min, 1025 min, 1026 min, 2137-2145, 2204 min, 2205, 2206 min, 2210, 2211, 2215 min, 2224, 2225, 2226 min, 2235, 2236, 2237 min, 2240 - 2315, 2469 - 2529, 2565-2568

158//18min, 23min
159//15min

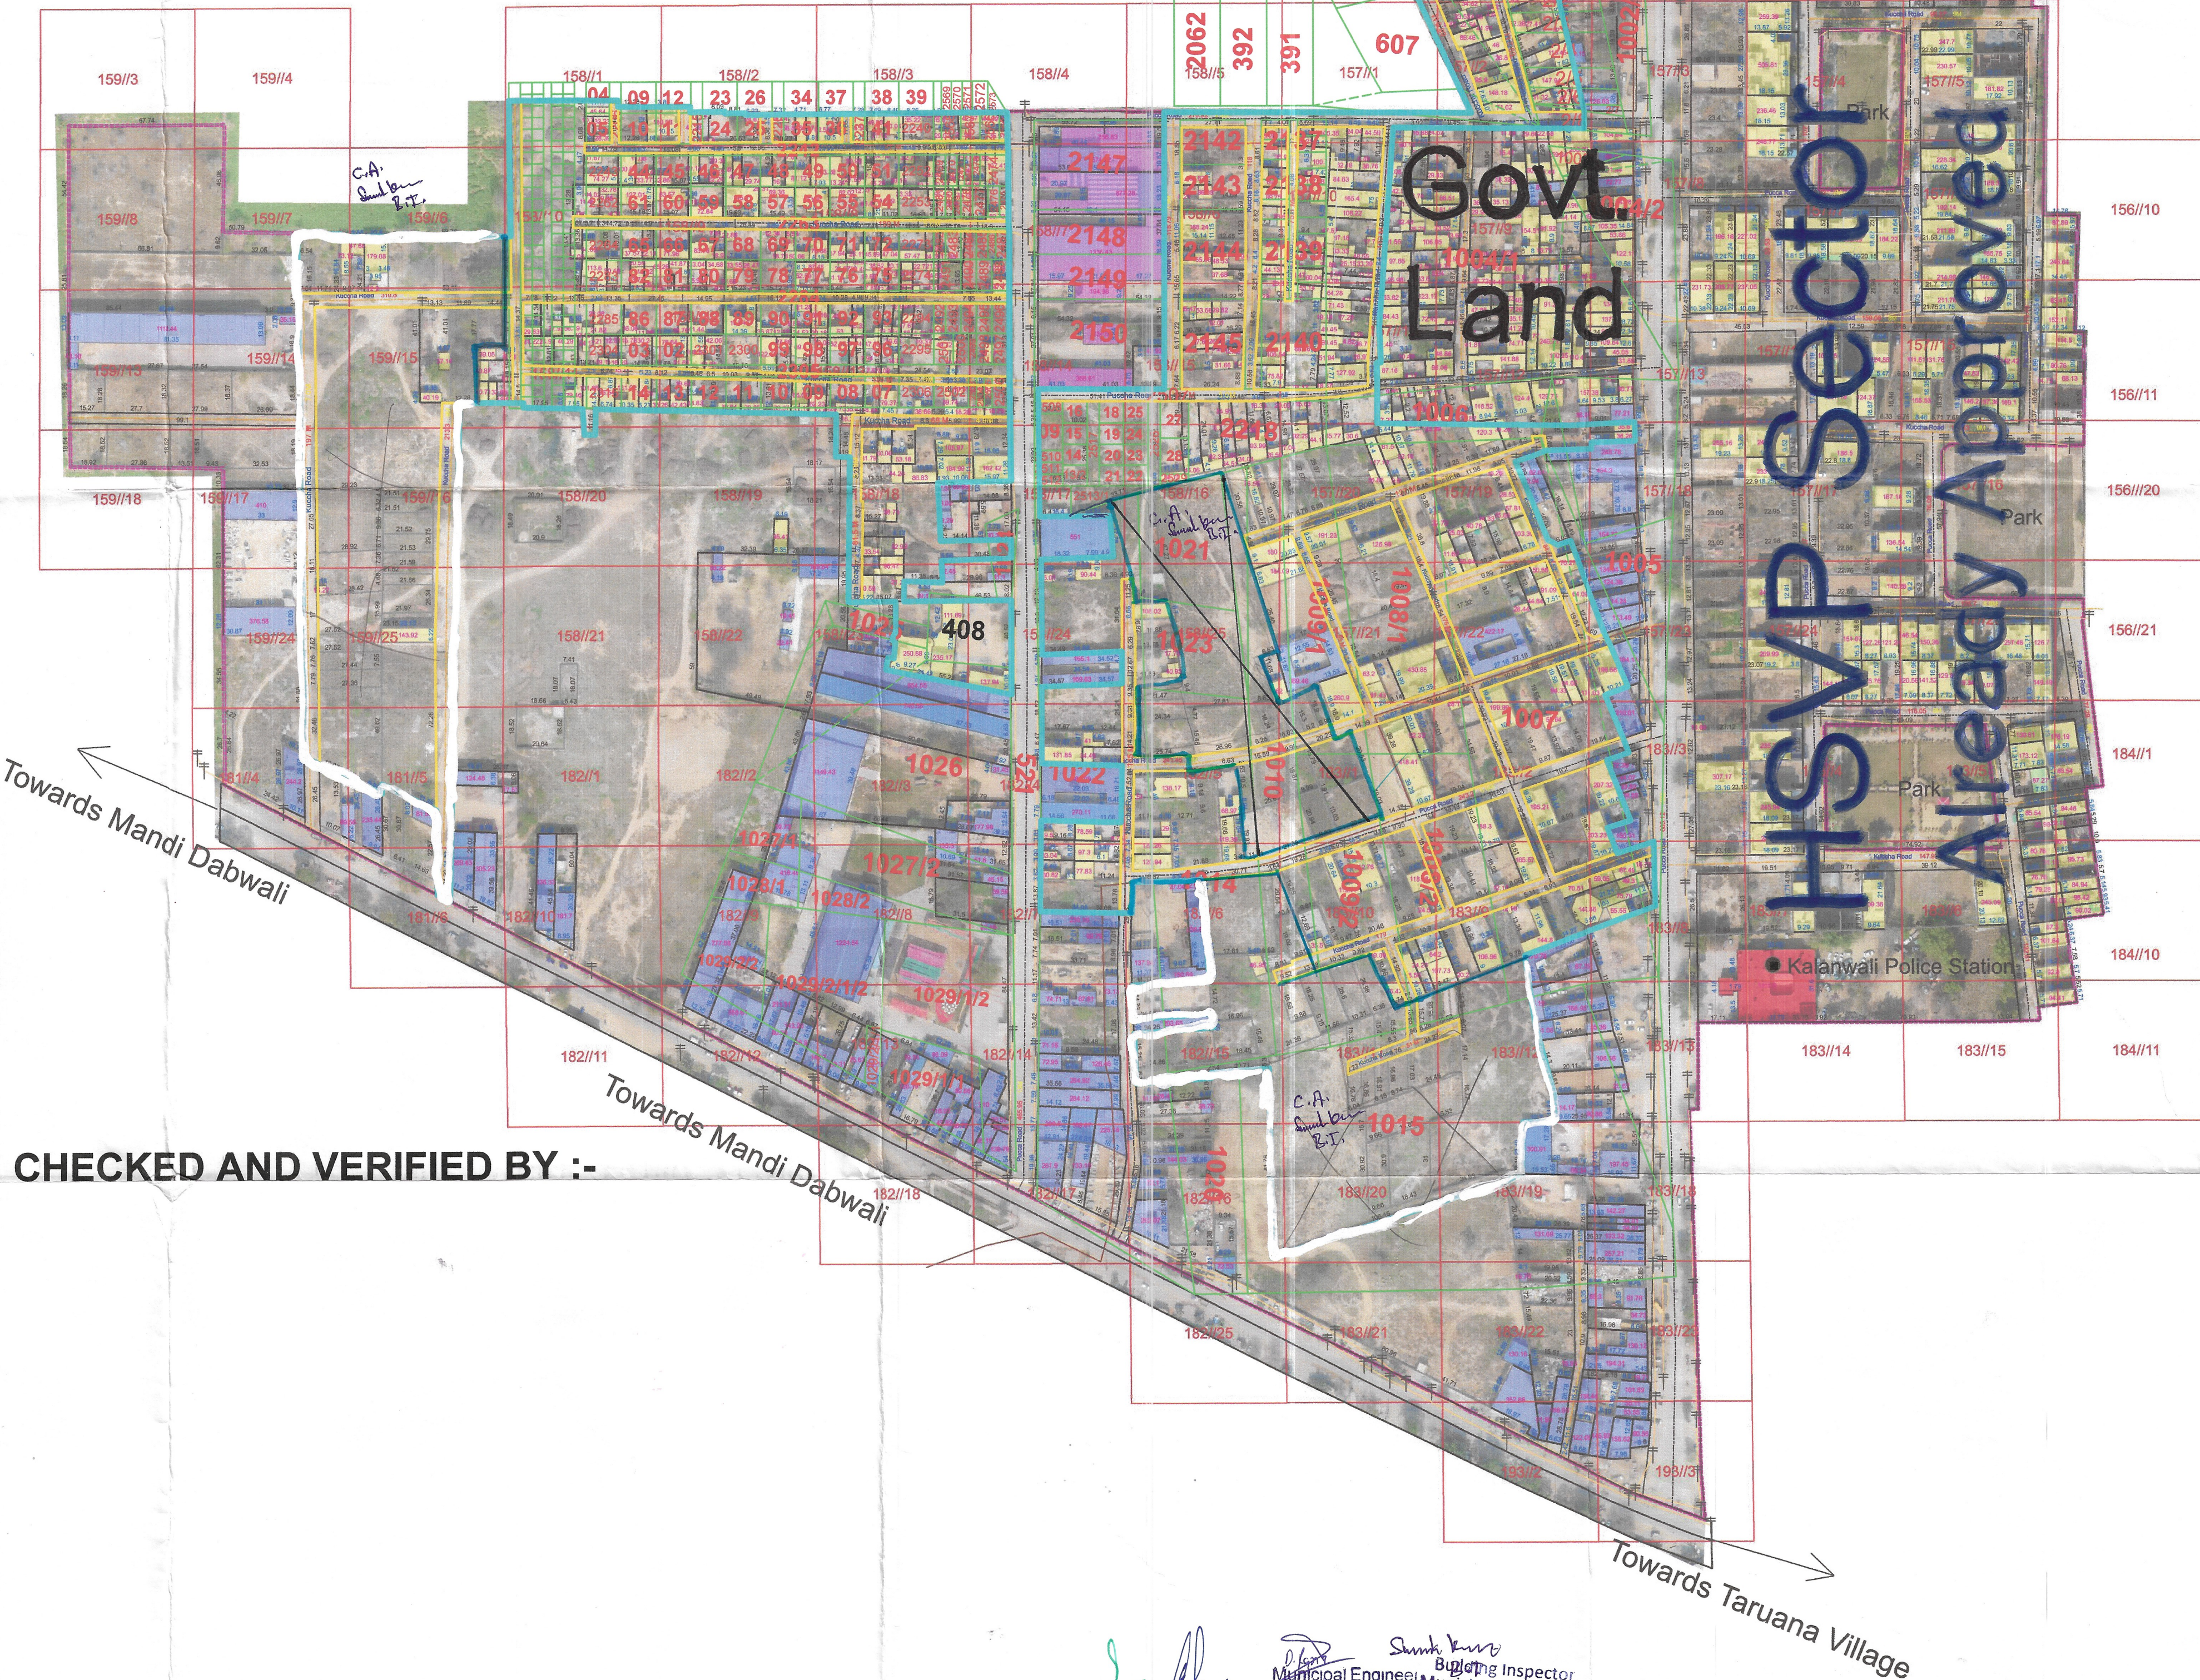

CHECKED AND VERIFIED BY :-

DRG. NO D.T.P. (S)	DT.
LAYOUT PLAN CHECKED AND VERIFIED AT SITE BY	
PATWARI :-	
FIELD INVESTIGATOR :-	
JUNIOR ENGG.:-	
ASSISTANT DRAFTSMAN :-	
DISTRICT TOWN PLANNER :-	
SENIOR TOWN PLANNER :-	
OFFICE OF DISTRICT TOWN PLANNER , SIRSA TOWN & COUNTRY PLANNING DEPTT, HARYANA	

This layout plan of unauthorised colony is approved and notified by the Government vide notification no. 09/45/2024 - 4C - II dated 6th March, 2024. The same be scanned for uploading on the web portal.

PE
Consultant/PE
ATP



LEGEND

- Airport
- Electric Pole
- Hospital
- Man Hole
- Mobile Tower
- Mosque
- School/College
- Solar Pole
- Street Light
- Temple
- Transformer
- HT Line
- LT Line
- Kuccha Road
- Pucca Road
- Major Road Line
- Drainage
- Sewerage Storm water
- Kuccha Road Polygon
- Pucca Road Polygon
- Residential
- Commercial
- Industrial
- Plot Boundary
- Vacant Land
- Park
- Colony Boundary
- Khasra Boundary
- Revenue Estate Boundary
- Mustil Boundary
- District Boundary
- Semi-Public

NOTE:-
* ALL DIMENSIONS ARE IN METERS AND AREA IN SQUARE METERS.
* AREA OF RESIDENTIAL BUILDINGS IS INDICATED THROUGH PINK COLOUR.
* AREA OF PLOT BOUNDARY IS INDICATED THROUGH PURPLE COLOUR.

SCALE : 1 CM = 10 M

DRONE SURVEY AND LAYOUT PLAN PREPARED BY:-



CHECKED :	SURVEYOR :	SCALE :-
DRAWN BY :-		
DRAWING NO :- UC-K-01	SHT. NO.	REV. NO.

Secretary
Municipal Committee
Kalanwali (Sirsa)

Inspector
Municipal Committee
Kalanwali

तहसीलदार
कालावाली