


DISTRICT JIND

LAYOUT PLAN OF UNAUTHORISED COLONY
NEAR JIND TO NARWANA ROAD
IN THE REVENUE ESTATE OF JIND
TEH.JIND AND DIST. JIND

KHASRA NO


24/1 min, 29/10 min, 11 min, 12, 13, 18 min,
19 min, 20 min, 21 min, 22 min

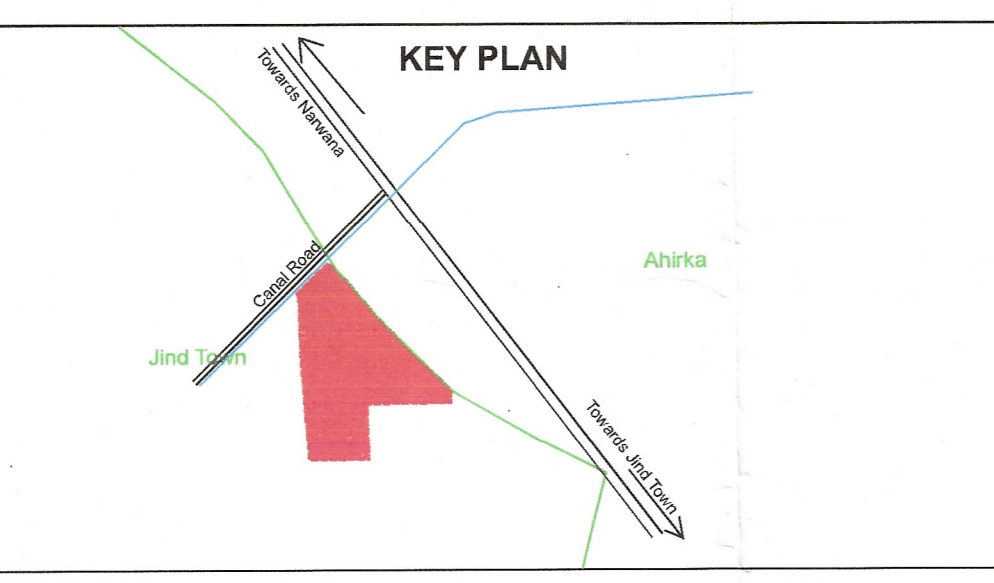

DETAILS OF UNAUTHORIZED COLONY

Sr. No.	Parameter Name	Description	
1	Colony name	Jind-UC-33	
2	Area	5.262 Acres 21297.97 Sq/M	
3	Location of the colony	Near Jind To Narwana Road	
4	Municipal Limits Boundary (MC STATUS):	(i) Within MC Yes (ii) Outside MC No (iii) Partial MC No	
	5	Type of Colony and use (in %)	Area (%) Area(Acres) Area(SQ/M)
		Residential	15% 0.801 3240.431
		Vacant + Open	61% 3.194 12928.080
Road		24% 1.267 5129.465	
Commercial		0% 0.000 0.000	
Industrial	0% 0.000 0.000		
Builtup	15% 0.801 3240.431		
6	Name of Revenue Estate	Jind	
7	District Name	Jind	
8	Name of Controlled Area	Jind	
9	Urban Area	Jind	
10	Year of establishment	2014	
11	Total No. of Plots	78	
12	No. of Constructed Plots (Residential+Commercial+Industrial)	43+0+0=43	
13	Number of vacant plots	35	
14	Number of families residing in the colony	43	
15	Does the colony have street light?	No	
16	Does the colony have Electric Line	Yes	
17	Does the colony have HT Line	No	
18	Does the colony have water supply through pipelines?	No	
19	Does the colony have underground sewerage facility?	Yes	
20	Does the colony have Park or Open space	No	
21	Road type on Colony (Kuccha/Pucca)	Kuccha	
22	Different roads (in meters)	Road Width Length (in mtrs)	
	Pucca Road	3 M to 9.8 M 915.26 M	
23	Minimum Road Width	3 M	
24	Area of the community site (in acres)	No	
25	Is the RWA registered	No	
26	Additional information, if any	No	
27	Name of Electric Substation	DHBVN	

This layout plan of unauthorised colony is approved and notified by the Government vide notification no. 04/42/2023 - 2C1 dated 6th October, 2023. The same be scanned for uploading on the web portal.
PE *[Signature]* Consultant/PE
Annis Polam ATP

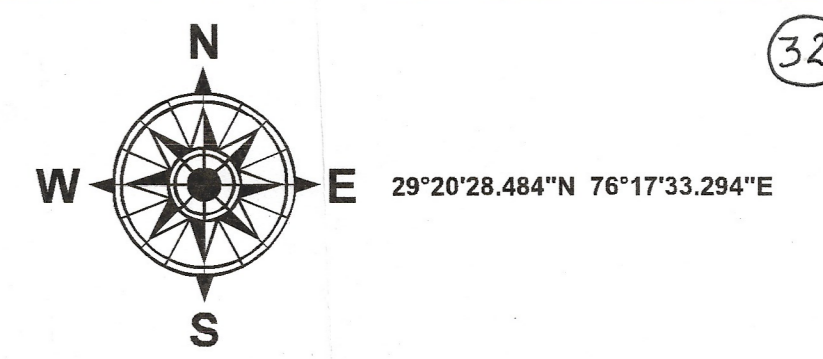

LEGEND

- Airport
- Electric Pole
- Hospital
- Manhole
- Mobile Tower
- Mosque
- School/College (Exclude)
- Solar Pole
- Street Light
- Temple
- Transformer
- HT line
- Kuccha Road
- Pucca Road
- Major Road Line
- Drainage
- Sewerage Storm water
- Kuccha Road Polygon
- Pucca Road Polygon
- Residential
- Commercial (Exclude)
- Industrial
- Plot Boundary
- Vacant Land
- Park
- Colony Boundary
- Khasra Boundary
- Revenue Estate Boundary
- Mustil Boundary
- District Boundary

NOTE:-
* ALL DIMENSIONS ARE IN METERS AND AREA IN SQUARE METERS.
* AREA OF RESIDENTIAL BUILDINGS IS INDICATED THROUGH PINK COLOUR.
* AREA OF PLOT BOUNDARY IS INDICATED THROUGH PURPLE COLOUR.



DRG. NO D.T.P. (J) DT.
LAYOUT PLAN CHECKED AND VERIFIED AT SITE BY:
PATWARI : *[Signature]*
JUNIOR ENGINEER: *[Signature]*
JUNIOR DRAFTSMAN : *[Signature]*
DISTRICT TOWN PLANNER : *[Signature]*
SENIOR TOWN PLANNER :
OFFICE OF DISTRICT TOWN PLANNER , JIND
TOWN & COUNTRY PLANNING DEPTT, HARYANA

District Municipal Commissioner
Executive Officer
Municipal Council, Jind
Executive Engineer
Municipal Council, Jind
[Signature]
Municipal Engineer
Municipal Council, Jind
[Signature]
Jind
[Signature]
M.C. Jind

SCALE : 1 CM = 10 M

DRONE SURVEY AND LAYOUT PLAN PREPARED BY:-

CHECKED : SURVEYOR : SCALE :-
DRAWN BY :-
DRAWING NO :- JUC-33 SHT. NO. REV. NO.