


DISTRICT JIND

LAYOUT PLAN OF UNAUTHORISED COLONY NEAR NEW ANAJ MANDI IN THE REVENUE ESTATE OF NARWANA TEH.NARWANA AND DIST. JIND

KHASRA NO
0/1555min

KEY PLAN

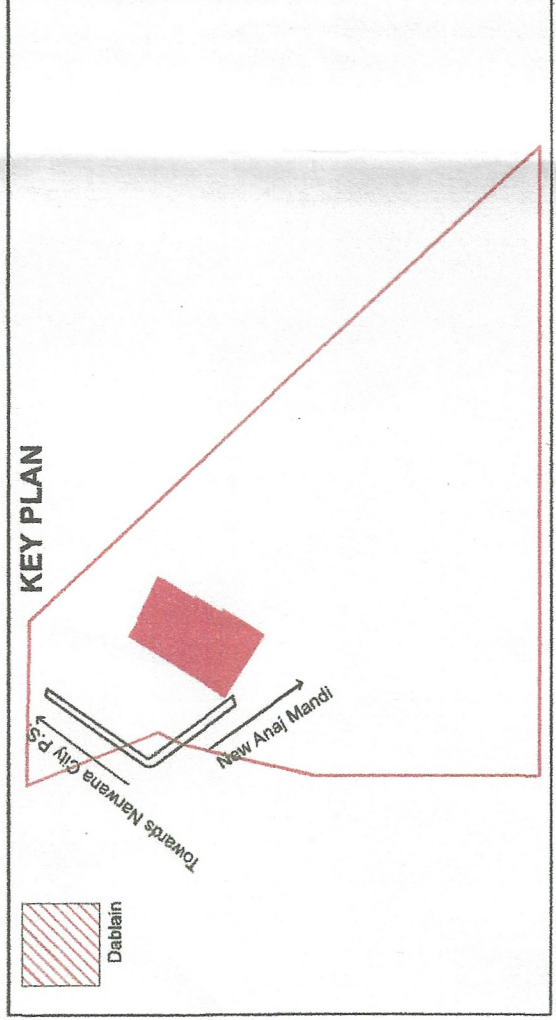

Sr. No.	Parameter Name	Description
1	Colony Name	Narwana-UC-17
2	Area	2.57 Acres
3	Location of the colony	38°27'57.96"N
4	Municipal Limits Boundary (MC STATUS):	(A) Within MC: No (B) Outside MC: No (C) Partial MC: No
5	Type of Colony and use (in %)	Residential: 80% Vacant & Open: 15% Commercial: 5% Industrial: 0% Bulldoz: 0% Name of Revenue Estate: Narwana
6	Name of Revenue Estate	Narwana
7	District Name	JIND
8	Name of Connected Area	MC Narwana
9	Year of Construction	1980
10	Year of Suburbance	50
11	Total No. of Ploos	50
12	No. of Constructed	50
13	Area of the colony (in sq.m)	1033.94
14	Number of families residing in the colony	115
15	Does the colony have street light?	Yes
16	Does the colony have Electric Line	Yes
17	Does the colony have HT Line	No
18	Does the colony have water supply through pipeline?	No
19	Does the colony have underground sewerage facility?	Yes
20	Does the colony have Park or Open space	Yes
21	Read type on Colony (Residential/Commercial)	Residential
22	Different roads (in meters)	Road Width: 2.76 to 9.13 M Pucca Road: 64.59
23	Minimum Road Width (in meters)	2.76
24	Area of the colony (in sq.m)	1033.94
25	Is the DWA registered	No
26	Additional information, if any	
27	Name of Electric Substation	DHRTA

DRG. NO D.T.P. (J) 144/8/2022 DT.

LAYOUT PLAN CHECKED AND VERIFIED AT SITE BY:

PATWARI: *Ravi*

JUNIOR ENGINEER: *Ravi*

JUNIOR DRAFTSMAN: *Ravi*

DISTRICT TOWN PLANNER: *Ravi*

SENIOR TOWN PLANNER: *Ravi*

OFFICE OF DISTRICT TOWN PLANNER, JIND TOWN & COUNTRY PLANNING DEPTT, HARYANA

FINAL AREA TO BE CONSIDERED FOR NOTIFICATION UC-17 Narwana

Area of colony surveyed (including khasra nos)	0/1555min
Area to be considered as per clause 5.1.b	Nil
Area of the colony falling under greenbelt/road/buffer zone/vacant land/madani etc/commercial (including khasra nos)	CV <i>Ravi</i>
Area of colony falling outside MC with khasra nos.	Nil
Area of colony to be considered for notification	0/1555min (Area)



- ### LEGEND
- Airport
 - Electric Pole
 - Hospital
 - Man Hole
 - Mobile Tower
 - Mosque
 - School/College
 - Solar Pole
 - Street Light
 - Temple
 - Transformer
 - HT Line
 - LT Line
 - Kuccha Road
 - Pucca Road
 - Major Road Line
 - Drainage
 - Sewerage Storm water
 - Kuccha Road Polygon
 - Pucca Road Polygon
 - Residential
 - Commercial
 - Industrial
 - Plot Boundary
 - Vacant Land
 - Park
 - Colony Boundary
 - Khasra Boundary
 - Revenue Estate Boundary
 - Musilli Boundary
 - District Boundary

NOTE:
 * ALL DIMENSIONS ARE IN METERS AND AREA IN SQUARE METERS.
 * AREA OF RESIDENTIAL BUILDINGS IS INDICATED THROUGH PINK COLOUR.
 * AREA OF PLOT BOUNDARY IS INDICATED THROUGH PURPLE COLOUR.

SCALE : 1 CM = 10 M

DRONE SURVEY AND LAYOUT PLAN PREPARED BY:-

CHECKED :-	SURVEYOR :-	SCALE :-
DRAWN BY :-	SFT. NO.	REV. NO.
DRAWING NO. :- UC-17		

This layout plan of unauthorised colony be approved and notified by the Government vide notification no. 09/09/2024 - 4C - II dated 01st February, 2024. The same be scanned for uploading on the web portal.

PE: *Ravi*
 Consultant/PE: *Anne Ravi* ATP

Ravi
 Junior Engineer
 M.C. Narwana

Ravi
 Executive Officer
 Municipal Council
 Narwana

Ravi
 District Municipal Comm. Isolation
 JIND

Ravi
 Municipal Engineer
 Municipal Council
 Narwana