


Residential & Commercial Zone


DISTRICT FARIDABAD

59/11 min, 12 min, 20 min, 19 min, 59/22 min, 23 min, 14 min, 19 min, 22 min, 23 min

59/14 min, 7 min, 13 min, 14 min, 24 min

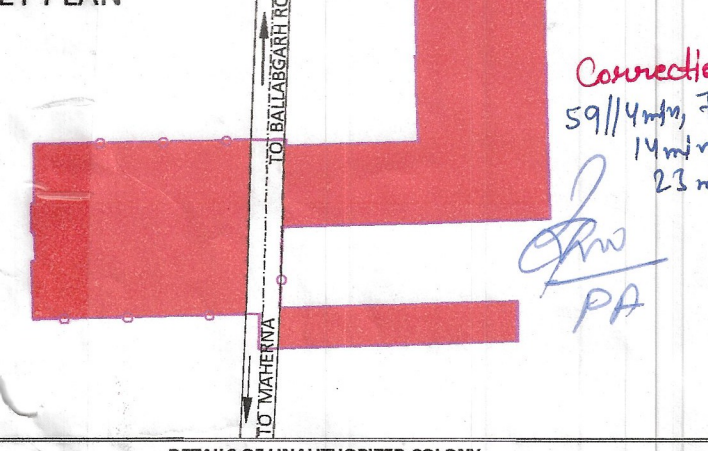

Sr. No.	Parameter Name	Description
1	Colony name	UNNAMED COLONY (ID-7122)
2	Area	6.92 Acres
3	Location of the colony	ON MAHERNA TO BALLABGARH ROAD
4	Type of Colony and use (in %)	Residential 39.84% Industrial 6.45%
5	Controlled Area	CONTROLLED AREA AROUND MUNICIPAL TOWN OF BALLABGARH
6	Urban Area	FARIDABAD
7	Year of establishment	2002
8	Layout Plan (Scale)	1:1000
9	Total Plots	NA
10	Constructed Plots (Residential-Industrial)	207 (9)-(9)-(216)
11	Number of vacant plots	NA
12	Number of families residing in the colony	207
13	Does the colony have Electricity?	Yes
14	Does the colony have water supply through pipelines?	No
15	Does the colony have underground sewerage facility?	No
16	If connected to any external Sewage treatment plant? (Y/N)	No
17	Does the colony have Park or Open space	NA
18	Road type on Colony (Kacha/Pucca)	Partly Kacha/Pucca
19	Minimum Road width	4.00M
20	Electricity provided to households through which sub station	SECTOR-58
21	Does the colony have community site	No
22	Area of the community site (in acres)	Nil
23	Is the RWA registered	NA
24	Additional Information, if any	NOTICE ISSUED

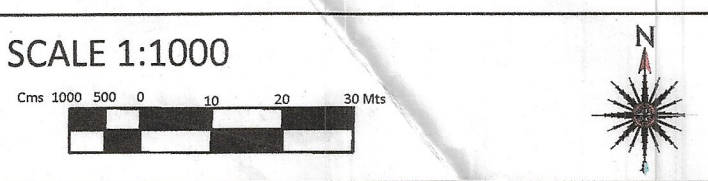

SCALE 1:1000

DRONE SURVEY AND LAYOUT PLAN PREPARED BY:-
PD CONSULTING ENGINEERS PVT.LTD

PDCE GROUP
TRANSFORMING QUALITY & BUDGET
hello@pdcegroup.com
www.pdcegroup.com
Red House, Behind MCD School,
Mehrauli-Gurgaon Rd, Ghitorni, Delhi - 30

Checked: PDCE Surveyor: RISHI PAL Sheet: A0
Drawn By: SHUBHAM Sht. No.: 1 OF 1 ID-7122

NOTE:
ALL DIMENSIONS ARE IN METERS AND AREA IN ACRES.

ORG. NO. DTP(E)-FBD/2022/ DATED: _____



POCKET-C
Details:-
Total Area of Site:-
(1) Pocket-I. Kh.No.

Residential Zone
SECTOR-63.

This layout plan of unauthorised colony is approved and notified by the Government vide notification no. 04/42/2023 - 2CI dated 25th July, 2023. The same be scanned for uploading on the web portal.

Signature of Consultant/PE
Signature of ATP

Signature of Patwari
Signature of Kanoogo

TEHSILDAR

NOTE -
TOTAL AREA OF COLONY = 6.92 ACRES

LEGEND							
Murraba Line		Commercial Area		Industrial Area		Divider Road	
Manhole/ Chamber		Khasra Line		Built Up Area/Residential		Vacant Plot (Not to be Regularised)	
TF/Electric/Mobile tower		Colony Boundary		Vacant Land/Plot		Temple/Mosque/Church/Flag Post	
Street Light/Solar pole		HT Line		Drain/Culvert / Bridge		Statue/School/Airport/Hospital/Well	
Revenue Boundary		Sewerage Line		Kaccha Road		Public & Semipublic Area	
City Road		Water Supply Line		Pacca Road		Tin Shed	

LAYOUT PLAN CHECKED AND VERIFIED AT SITE BY:-
PATWARI _____
JUNIOR ENGG. _____
ASSISTANT TOWN PLANNER _____
DISTRICT TOWN PLANNER _____
SENIOR TOWN PLANNER _____
OFFICE-DISTRICT TOWN PLANNER(ENF), FARIDABAD
TOWN & COUNTRY PLANNING DEPTT., HARYANA

Signature of D/M
Signature of J-E
Signature of DTP
Signature of CTP
Signature of CMC
Signature of D.M. CMC