


DISTRICT - SIRSA

LAYOUT PLAN OF UNAUTHORISED COLONY NEAR SIRSA TO DABWALI ROAD IN THE REVENUE ESTATE OF VILL CHATTAR GAR TEH. SIRSA, DIST. SIRSA

KHASRA NO -
 53/10m, 11m, 20m, 12m, 14m, 15m, 19m,
 54/3m, 6m, 9m, 9m, 24m, 25m,
 20m, 21m, 22m, 24m, 25m,
 55/1, 6m, 12m, 13m, 14m, 16m, 17m, 18, 19m,
 59/5m, 6m, 20m, 21m, 22m, 23m, 24m, 25m,
 60/1m, 2m, 3, 4, 5, 6, 7, 8, 9, 10
 61/1, 2, 3, 4, 5

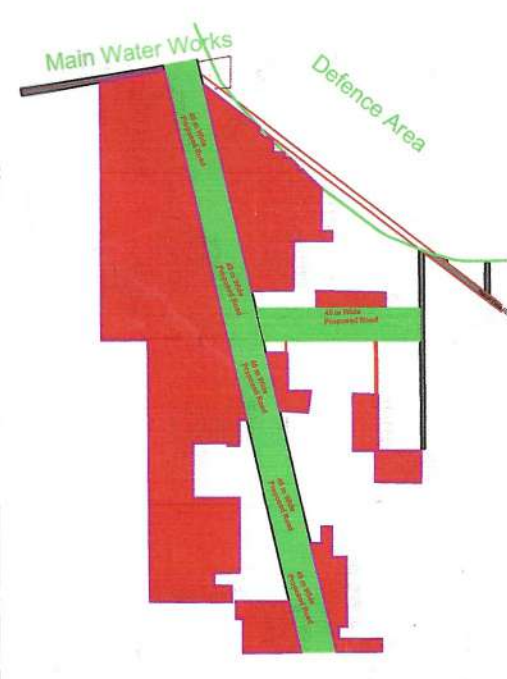


KEY PLAN

DETAILS OF UNAUTHORISED COLONY

Sr. No.	Parameter Name	Description
1	Colony name	UC-S-34
2	Area	28.85 Acres 11878 SqM
3	Location of the colony	Near Main Water Works, Sirsa
4	Municipal limits boundary (MC Status)	(1) Within MC Yes (2) Outside MC No (3) Partial MC No
5	Type of Colony and use (in %)	Residential 41% Vacant - Open 42% Road 17% Commercial 0% Industrial 0% Bulldoz 41%
6	Name of Revenue Estate	Chattr Garh
7	District Name	Sirsa
8	Name of Controlled Area	Sirsa
9	Urban Area	Sirsa
10	Year of establishment	2002
11	Total No. of Plots	672
12	No. of Constructed Plots (Residential + Commercial + Industrial)	419+0+0 = 419
13	Number of vacant plots	253
14	Number of families residing in the colony	419
15	Does the colony have street light?	Yes
16	Does the colony have Electric Line	Yes
17	Does the colony have H.T. Line	No
18	Does the colony have water supply through pipelines?	Yes
19	Does the colony have underground sewerage facility?	Yes
20	Does the colony have Park or Open space	No
21	Road type on Colony (Kuchha/Pucca)	Kuchha & Pucca
22	Different roads (in meters)	Road Width Length (in mts) 4.5 M to 8.5 M 1354 M 3.3 M TO 9 M 613 M
23	Minimum Road width	3.3 M
24	Area of the community (stain acres)	No
25	Is the RWA registered	No
26	Additional Information, if any	No
27	Name of Electric Sub station	Sirsa

DRG. NO. D.T.P. (S) DT.

LAYOUT PLAN CHECKED AND VERIFIED AT SITE BY
 PATWARI :-
 FIELD INVESTIGATOR :-
 JUNIOR ENGG. :-
 ASSISTANT DRAFTSMAN :-
 DISTRICT TOWN PLANNER :-
 SENIOR TOWN PLANNER :-

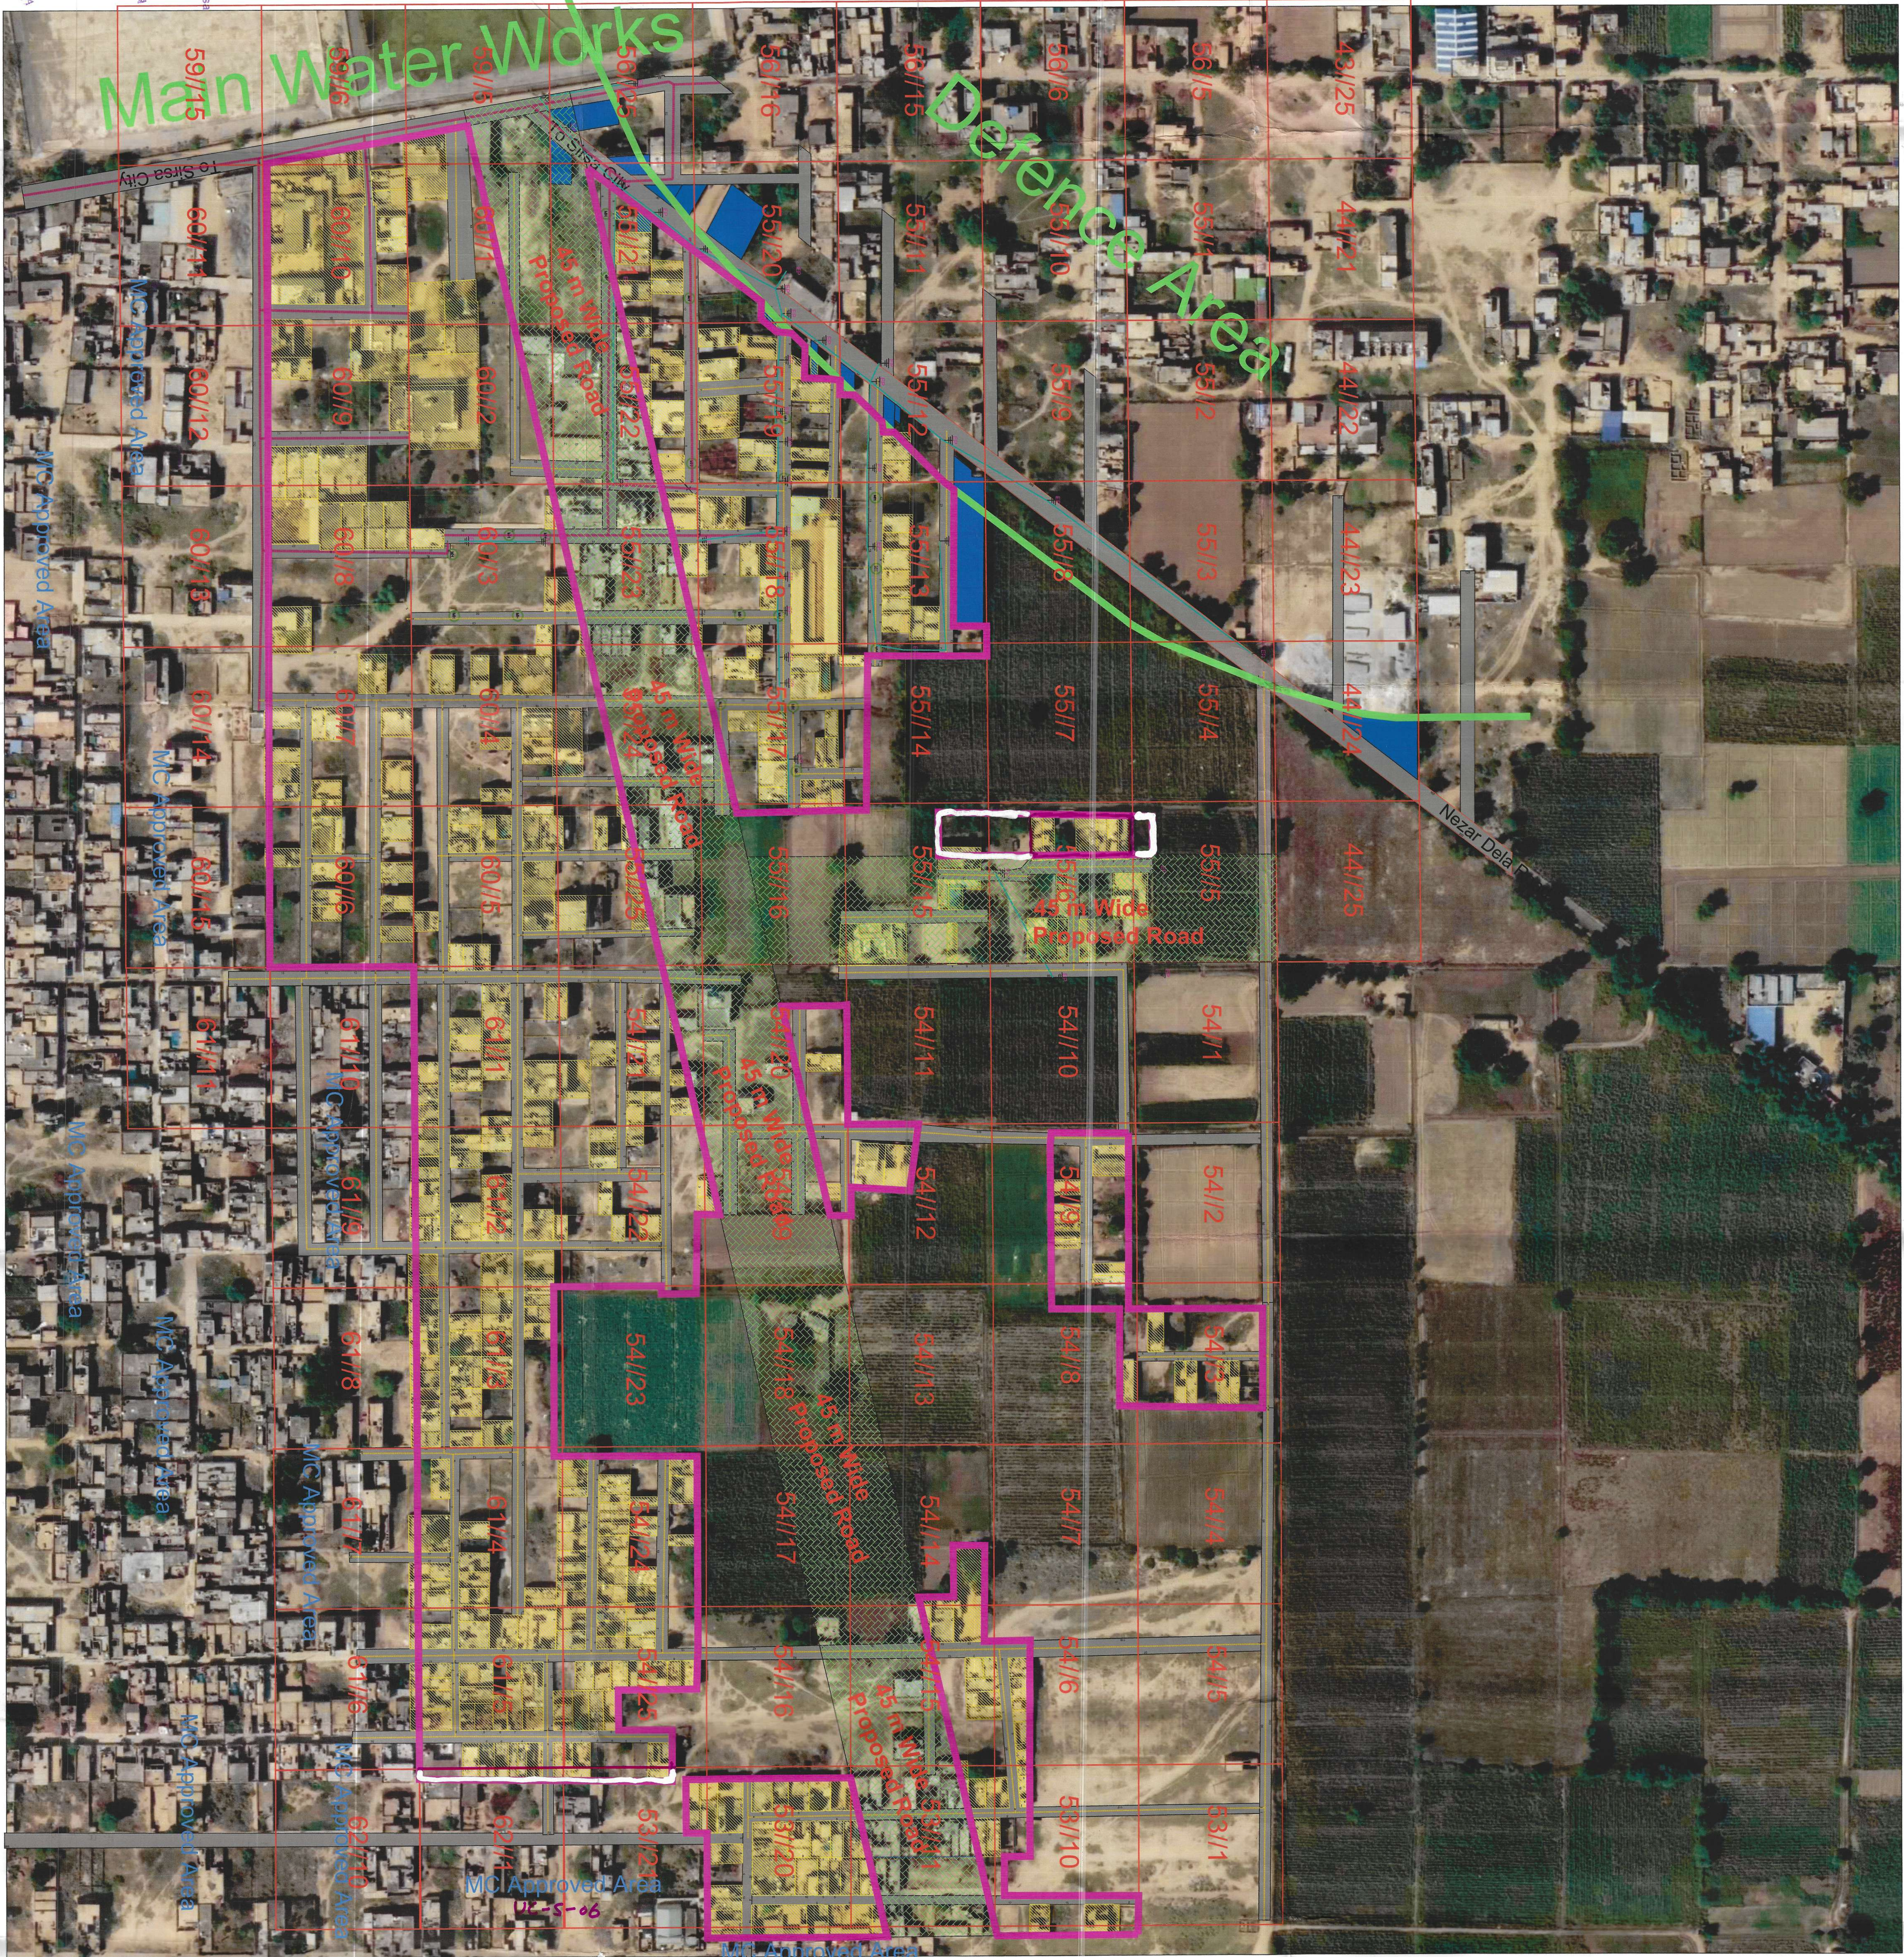

LEGEND

	Airport
	Electric Pole
	Hospital
	Manhole
	Mobile Tower
	Mosque
	School/College
	Solar Pole
	Street Light
	Temple
	Transformer
	HT Line
	LT Line
	Kuchha Road
	Pucca Road
	Major Road Line
	Drainage
	Sewerage Storm Water
	Defence Area
	Internal Colony Road
	Residential
	Commercial
	Industrial
	Semi Public
	Plot Boundary
	Vacant Land
	Park
	Colony Boundary
	Khasra Boundary
	MC Boundary
	Proposed Road

NOTE :-
 1. ALL DIMENSION AREA IN METERS AND AREA IN SQUARE METERS.
 2. AREA OF RESIDENTIAL BUILDINGS IS INDICATED THROUGH PINK COLOUR.
 3. AREA OF PLOT BOUNDARY IS INDICATED THROUGH PURPLE COLOUR.

SCALE : 1 CM = 10 M

LAYOUT PLAN PREPARED BY :-
Technifra Solutions
 1st Floor, B.K. Tailor, Old Bus Stand,
 Jind Road, Nanarand, Hisar-126039, Haryana (India)
 M. +91-9812552291 | Email: sandeep.technifra@gmail.com
 Website: http://www.technifra.in

Checked by: _____
 Drawn by: _____
 Drawing No.: UC-D-9/PART-B