

DISTRICT SIRSA


LAYOUT PLAN OF UNAUTHORIZED COLONY NEAR SIRSA TO RANGRI ROAD IN THE REVENUE ESTATE OF VILL KHAJA KHERRA TEH. SIRSA, DIST. SIRSA

KHASRA NO -

74//8min, 9min, 10min, 11min, 12, 13, 14min, 17min,

Not recommended

KEY PLAN

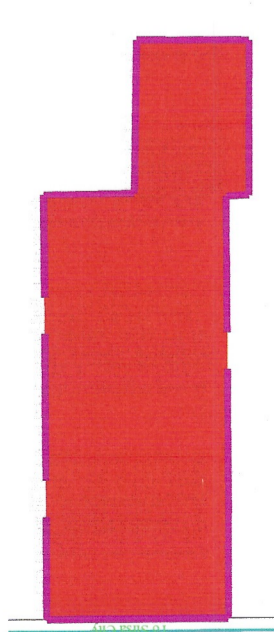

DETAILS OF UNAUTHORISED COLONY


Sr. No.	Parameter Name	Description
1	Colony name	UCS-30
2	Area	4.45 Acres 1798 Sqm
3	Location of the colony	Sirsa To Rangri Road
4	Municipal Limits Boundary (MC Status)	(1) Within MC Yes (2) Outside MC No (3) Partial MC No
5	Type of Colony and use (in %)	Residential 0% Vacant + Open 77% Road 13% Commercial 0% Industrial 0% Bulldoz 0%
6	Name of Revenue Estate	Khaja Kherra
7	District Name	Sirsa
8	Name of Controlled Area	Sirsa
9	Urban Area	Sirsa
10	Year of establishment	2019
11	Total No. of Plots	4
12	No of Constructed Plots (Residential + Commercial + Industrial)	0+0+0=0
13	Number of vacant plots	4
14	Number of families residing in the colony	0
15	Does the colony have street light?	No
16	Does the colony have Electric Line	Yes
17	Does the colony have H.T. Line	No
18	Does the colony have water supply through pipelines?	Yes
19	Does the colony have underground sewerage facility?	No
20	Does the colony have Park or Open space	No
21	Road type on Colony (kuccha/pucca)	Kuccha
22	Different roads (in meters)	Road Width Length (in mtrs) 0 0 Pucca Road 6 M to 10 M 488.21 M Kuchha Road 6 M
23	Minimum Road width	6 M
24	Area of the community site (in acres)	No
25	Is the RWA registered	No
26	Additional Information, if any	No
27	Name of Electric Sub station	Sirsa

DRG. NO. D.T.P. (S) DT.

LAYOUT PLAN CHECKED AND VERIFIED AT SITE BY

PATWARI :
FIELD INVESTIGATOR :
JUNIOR ENGG :
ASSISTANT DRAFTSMAN :
DISTRICT TOWN PLANNER :
SENIOR TOWN PLANNER :

OFFICE OF DISTRICT TOWN PLANNER, SIRSA
TOWN & COUNTRY PLANNING DEPT., HARYANA

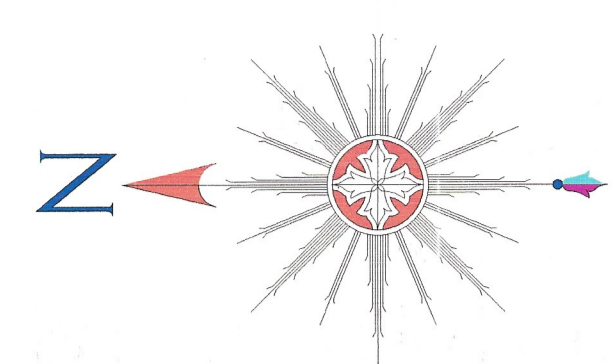

LEGEND	
	Airport
	Electric Pole
	Hospital
	Manhole
	Mobile Tower
	Mosque
	School/College
	Solar Pole
	Street Light
	Temple
	Transformer
	HT Line
	LT Line
	Kuccha Road
	Pucca Road
	Major Road Line
	Drainage
	Sewerage Storm Water
	Revenue Boundary
	Internal Colony Road
	Residential
	Commercial
	Industrial
	Semi Public
	Plot Boundary
	Vacant Land
	Park
	Colony Boundary
	Khasra Boundary
	MC Boundary
	Proposed Road

NOTE :-
1. ALL DIMENSION AREA IN METERS AND AREA IN SQUARE METERS.
2. AREA OF RESIDENTIAL BUILDINGS IS INDICATED THROUGH
3. AREA OF PLOT BOUNDARY IS INDICATED THROUGH PURPLE COLOUR.

SCALE : 1 CM = 10 M

LAYOUT PLAN PREPARED BY :-

Technifra SOLUTIONS

1st Floor, R.K. Tallor, Old Bus Stand,
Jind Road, Narnaud, Hisar-125039, Haryana (India)
M: +91-9812622299 | Email: sanjeeptechinfr@gmail.com
Website: http://www.technifra.in

Checked By: _____
Drawn By: _____
Scale: _____
Surveyor: _____
Sht. No.: _____
Rev. No.: _____

This layout plan of unauthorized colony is approved and issued on 18/02/2024. It shall be valid till February, 2024. The same shall be cancelled if not updated on the web portal.