

DISTRICT ROHTAK

LAYOUT PLAN OF RAJIV NAGAR COLONY (C/N), SITUATED IN THE REVENUE ESTATE OF VILLAGE ROHTAK TEHSIL AND DISTRICT ROHTAK COMPRISING IN KIASRAKULLA NO. -




KEY PLAN



DETAILS OF UNAUTHORIZED COLONY

Sr. No.	Parameter Name	Description
1	Colony Name	Rajiv Nagar Colony
2	Area	1038 Acres
3	Location of the colony	Near by Power house
4	Waste M.C.	Yes
5	Quota M.C.	No
6	Type of Colony and use (a/b)	Residential
7	Year of establishment	2009
8	Layout Area Scale	1:1000
9	Total Area	68 - 2 - 0 = 70
10	Number of vacant plots	80
11	Does the colony have street light?	No
12	Does the colony have water supply through pipelines?	No
13	Does the colony have underground sewerage system?	No
14	Is the colony registered in the Revenue Deptt? (Y/N)	No
15	Does the colony have Park or Open Space?	No
16	Road type on Colony (Rural/Physical)	Physical Road/Physical
17	Width of reference road (in meter)	3M to 4.5M
18	Minimum Road width	3M
19	Minimum provision to households	Sub Station/Retak
20	Area of the colony (in acre)	No
21	Is the colony registered in the Revenue Deptt?	No
22	Additional Information, if any	---

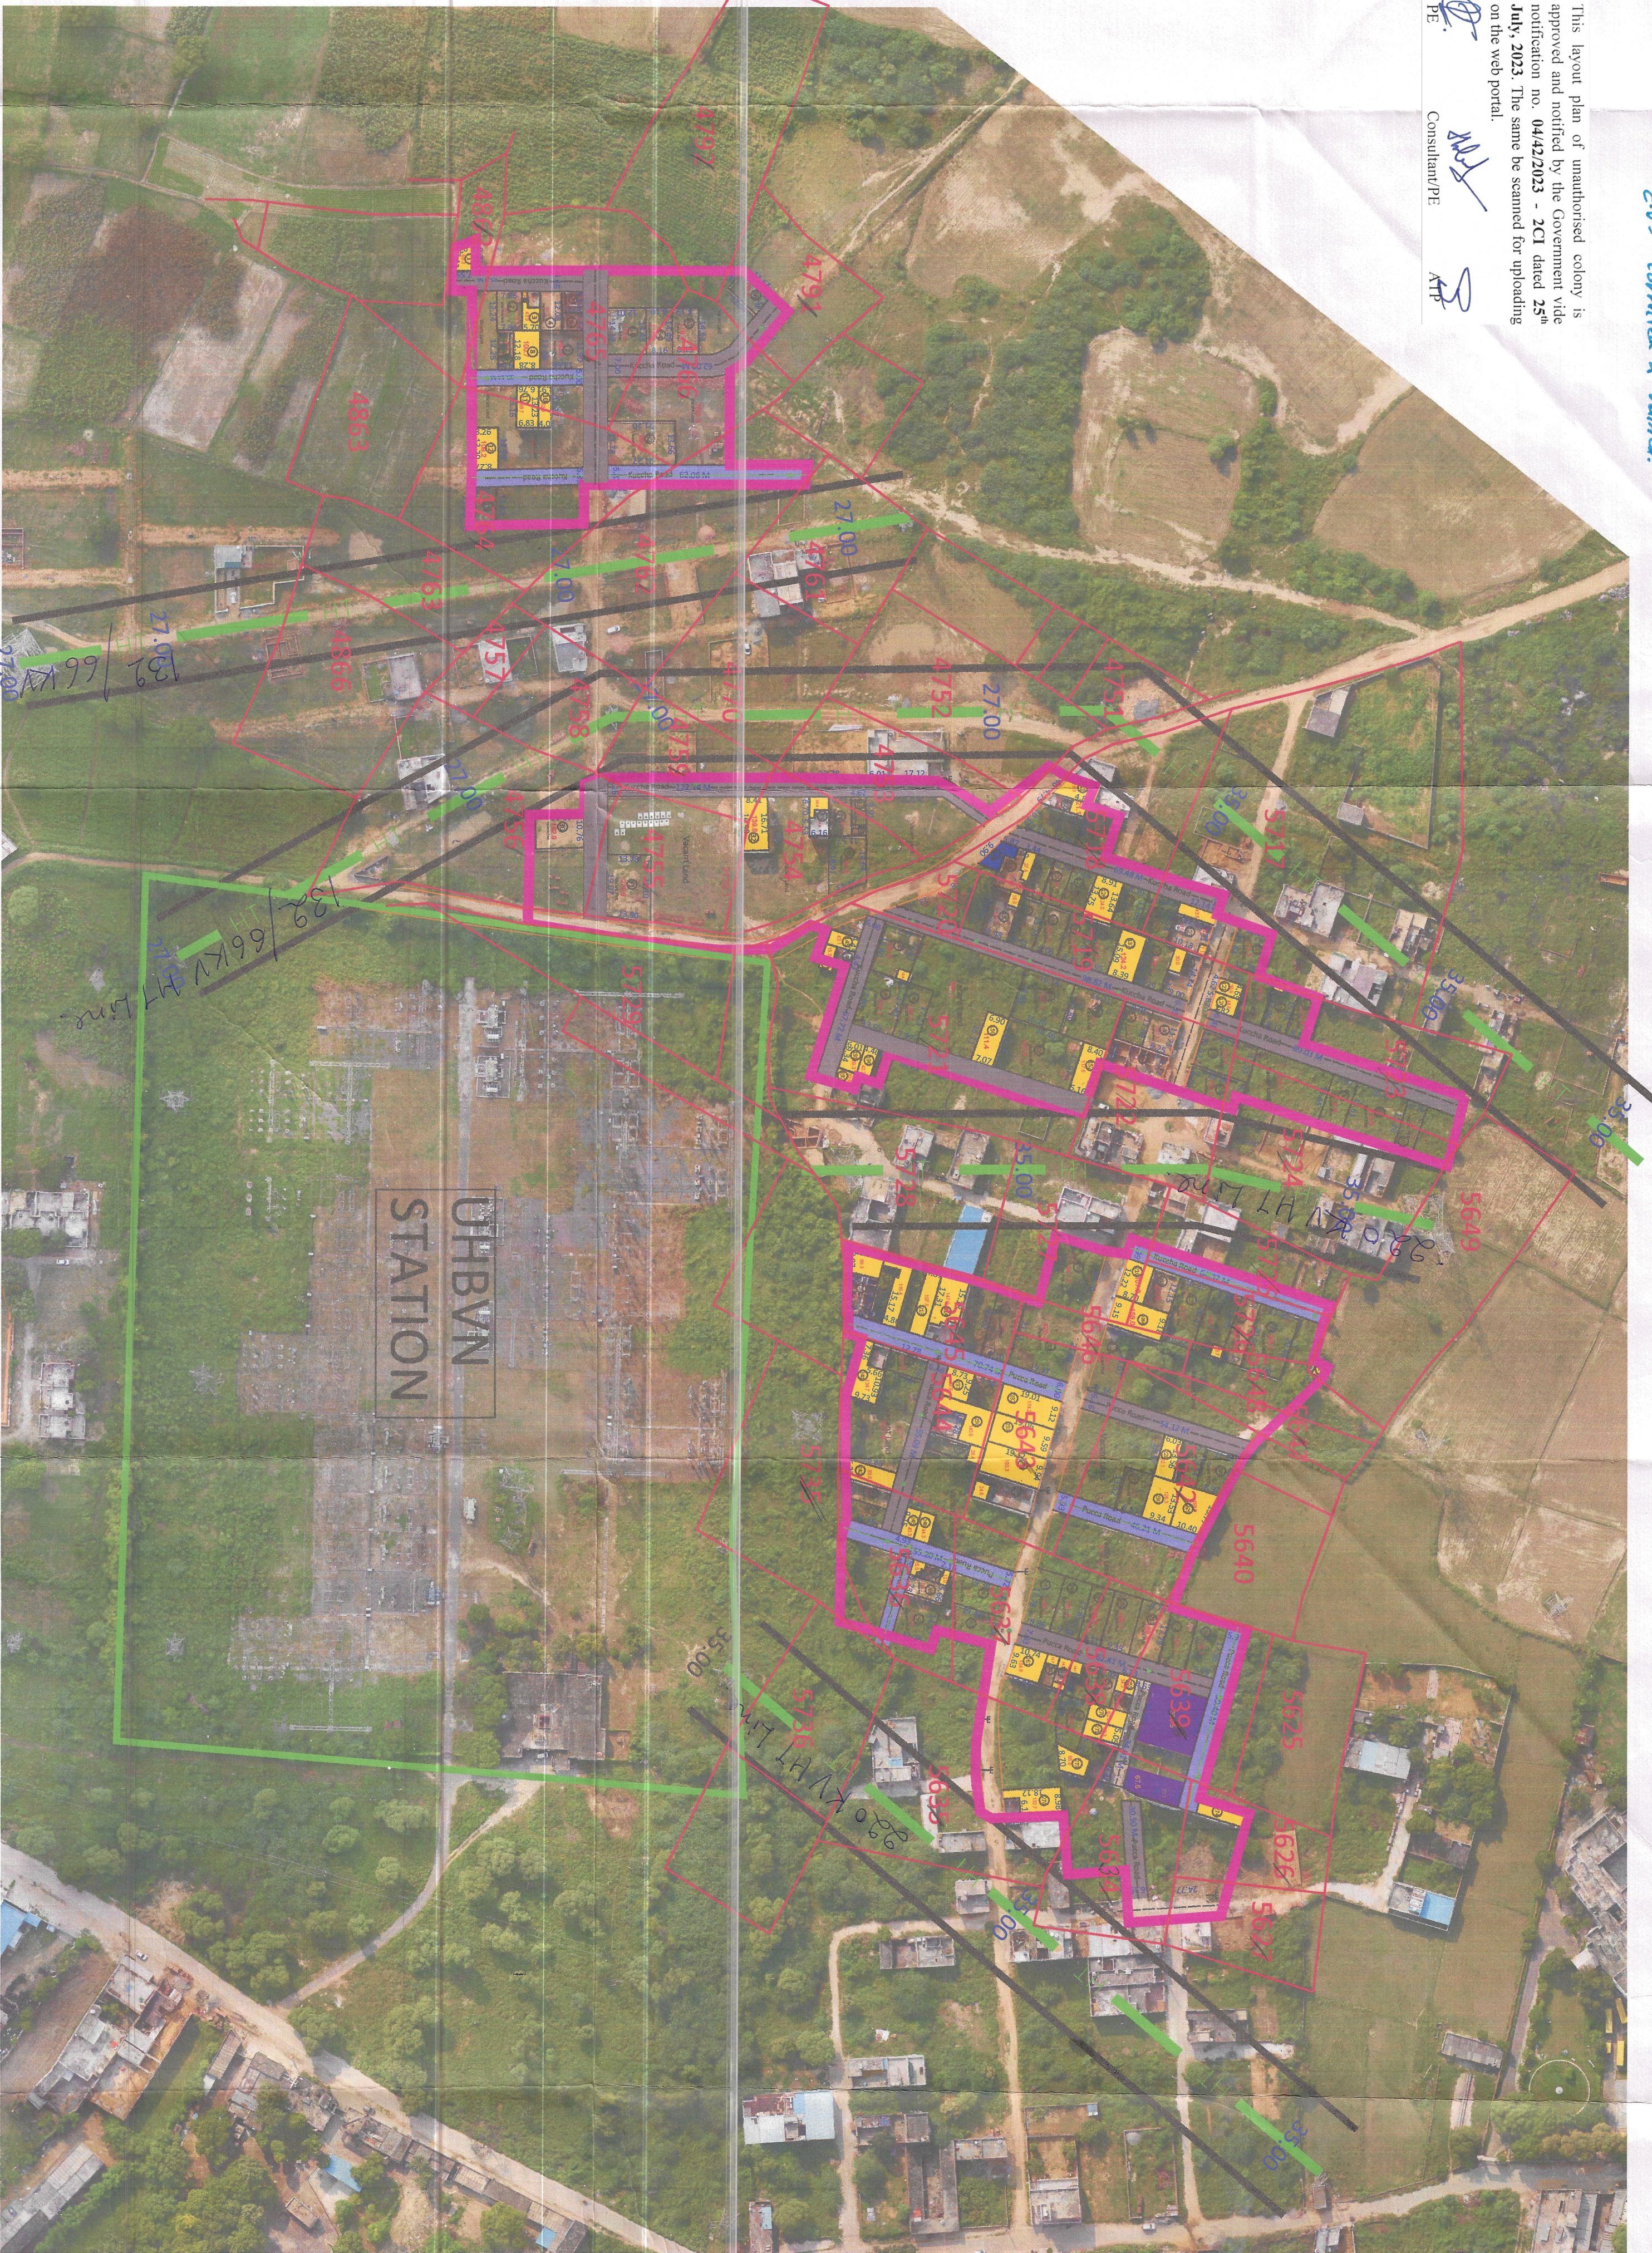

LPT-28-92-1920 LonN-76-577308

This layout plan of unauthorized colony is approved and notified by the Government vide notification no. 04/42/2023 - 2C1 dated 25th July, 2023. The same be scanned for uploading on the web portal.

Cv- Conceded & Valid.


Consuldar/PE

LEGEND

Symbol	Description
[Green Circle]	Manhole/Chamber
[Red Square]	Transformer/Electric Pole/Mobile Tower
[Blue Line]	Street Light/Solar Pole
[Red Line]	Revenue Boundary
[Blue Line]	City Road
[Orange Line]	Kulera Line
[Black Line]	Miramba Line
[Pink Line]	Colony Boundary
[Green Line]	HT Line
[Yellow Line]	Sewerage Line
[Red Line]	Kachcha Road
[White Box]	Vacant Land (Not to be Regulated) (Area in Acre)
[Blue Box]	Tim Shed
[Red Box]	Public & Semi-public Area (Area in Acre)
[Blue Box]	Commercial Area
[Yellow Box]	Residential Area
[Green Box]	Industrial Area
[Blue Box]	Drain / Culvert / Bridge
[White Box]	Peon Road
[Green Box]	Temple/Mosque/Church/Jing Place/Sewa Sandhan
[Blue Box]	Sanitary/Technical/Drainage/Institution/Wall
[Red Box]	AREA NOT TO BE CONSIDERED
[Blue Box]	AREA UNDER PROPOSED ROAD
[Green Box]	AREA UNDER GREEN BELT

LEGEND

Sr. No.	Width of Internal Roads	Color
1	UP TO 1.5M	Red
2	1.5 - 2M	Orange
3	2 - 2.5M	Yellow
4	2.5 - 3M	Green
5	3 - 4M	Blue
6	4 - 5M	Light Blue
7	ABOVE 5M	Dark Blue

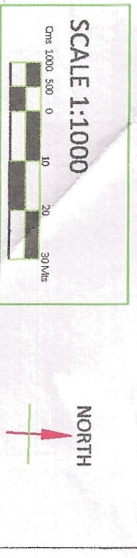

SCALE 1:1000

NORTH

PD CONSULTING ENGINEERS PVT LTD




DRG. NO. 07/18 DATED 14.02.2022 (17-2-2023)

LAYOUT PLAN CHECKED AND VERIFIED AT SITE BY: JUNIOR ENGINEER (MUT) ROHTAK

ASSISTANT DEPUTY MAGISTRAR (CITY) ROHTAK

JUNIOR DEPUTY MAGISTRAR SENIOR DEPUTY MAGISTRAR PLANNING ASSISTANT ASSISTANT TOWN PLANNER (MANAGEMENT) DISTRICT TOWN PLANNER (SOM/REGD)

OFFICE OF DISTRICT TOWN PLANNER, ROHTAK TOWN & COUNTRY PLANNING DEPTT., HARYANA

Fire Safety Officer ROHTAK

[Signature]

[Signature]

