PRODUCED BY AN AUTODESK EDUCATIONAL PRODUCT


DISTRICT SIRSA

LAYOUT PLAN OF UNAUTHORIZED COLONY NEAR NEAR BEGU ROAD SIRSA
IN THE REVENUE ESTATE OF VILL SHAHPUR BEGU TEH. SIRSA , DIST. SIRSA

KHASRA NO -
39//13Min,14,15,16Min,17min
40/11Min

Not recommended due to Approach road less than 6m

KEY PLAN

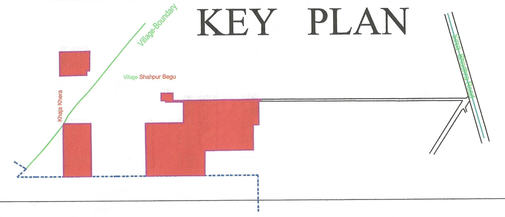

DETAILS OF UNAUTHORISED COLONY

Sr. No.	Parameter Name	Description		
1	Colony name	Milk Plant Ke Peeche Colony No.2 (S_UC_83)		
2	Area	4.47 Acres	18130.56 Sq/M	
3	Location of the colony	Sirsa To Bhadra Road		
4	Municipal Limits Boundary (MC Status):	(1) Within MC	Yes	
		(2) Outside MC	No	
		3) Partial MC	No	
5	Type of Colony and use (in %)		Area(%)	Area(Acres)	Area(Sq/M)
		Residential	22%	0.98	3970.34
		Vacant + Open	57%	2.57	10403.07
		Road	21%	0.92	3757.15
		Commercial	0%	0.00	0
		Industrial	0%	0.00	0
		Builtup	22%	0.98	3970.34
6	Name of Revenue Estate	Shahpur Begu and Khaja Khera		
7	District Name	Sirsa		
8	Name of Controlled Area	Sirsa		
9	Urban Area	Sirsa		
10	Year of establishment	2011		
11	Total No. of Plots	63		
12	No.of Constructed Plots (Residential + Commercial + Industrial)	38+0+0 = 38		
13	Number of vacant plots	25		
14	Number of families residing in the colony	38		
15	Does the colony have street light?	No		
16	Does the colony have Electric Line	Yes		
17	Does the colony have H.T. Line	No		
18	Does the colony have water supply through pipelines?	Yes		
19	Does the colony have underground sewerage facility?	No		
20	Does the colony have Park or Open space	No		
21	Road type on Colony (kuchha/pucca)	Kuchha		
22	Different roads (in meters)	Road Width	Length (in mtrs)	
	Pucca Road	N/A	N/A	
	Kuchha Road	3.3 M TO 5.3 M	855.68 M	
23	Minimum Road width	3.3 M		
24	Area of the community site(in acres)	No		
25	Is the RWA registered	No		
26	Additional Information, if any	No		
27	Name of Electric Sub station	Sirsa		

DRG. NO. D.T.P. (S) DT.

LAYOUT PLAN CHECKED AND VERIFIED AT SITE BY

PATWARI :-

FIELD INVESTIGATOR :-

JUNIOR ENGG :-

ASSISTANT DRAFTSMAN :-

DISTRICT TOWN PLANNER :-

SENIOR TOWN PLANNER :-

Junior Engineer
Municipal Council, Sirsa

Tehsildar
Sirsa

Municipal Engineer
Municipal Council, SIRSA

Executive Engineer
Municipal Council, Sirsa

Executive Officer
Municipal Council, SIRSA

District Municipal Commissioner,
Sirsa

OFFICE OF DISTRICT TOWN PLANNER , SIRSA
TOWN & COUNTRY PLANNING DEPTT , HARYANA



This layout plan of unauthorised colony is approved and notified by the Government vide notification no. **09/19/2024 - 4C - II** dated **01st February, 2024**. The same be scanned for uploading on the web portal.

PE Consultant/PE ATP

N

LEGEND

	Airport
	Electrice Pole
	Hospital
	Manhole
	Mobile Tower
	Mosque
	School/College
	Solar Pole
	Street Light
	Temple
	Transformer
	HT Line
	LT Line
	Kuccha Road
	Pucca Road
	Major Road Line
	Drainage
	Sewerage Storm Water
	Revenu Boundary
	Internal Colony Road
	Residential
	Commercial
	Industrial
	Semi Public
	Plot Boundary
	Vacant Land
	Park
	Colony Boundary
	Khasra Boundary
	MC Boundary
	Proposed Road

NOTE : -

1. ALL DIMENSION AREA IN METERS AND AREA IN SQUARE METERS.
2. AREA OF RESIDENTIAL BUILDINGS IN INDICATED THROUGH PINK COLOUR.
3. AREA OF PLOT BOUNDARY IS INDICATED THROUGH PURPLE COLOUR.

SCALE : 1 CM = 10 M (0 12.5 25 50 75 M)

LAYOUT PLAN PREPARED BY : -

Techinfra Solution's
TECHINFRA SOLUTION'S
1st Floor, R.K. Tailor, Old Bus Stand,
Jind Road, Narnaund, Hisar-125039, Haryana [India]
M: +91-9812652298 | Email: sandeep.techinfra@gmail.com
Website: http://www.techinfra.in

Checked :	Surveyor :	Scale
Drawn By:		
Drawing No : U C - D -9 PART - B	Sht. No.	Rev. No.

PRODUCED BY AN AUTODESK EDUCATIONAL PRODUCT