


# DISTRICT FARIDABAD


THE REVENUE ESTATE OF VILLAGE -FARIDPUR, TEHSIL-FARIDABAD, DISTRICT-FARIDABAD Colony ID 7341  
 COMPRISING IN KHASRA NO. 26/22min,23,24min,28;  
 33//2min,3min,4min,8,12min,14min,17,18min,19min,22, 23min,

## KEY PLAN

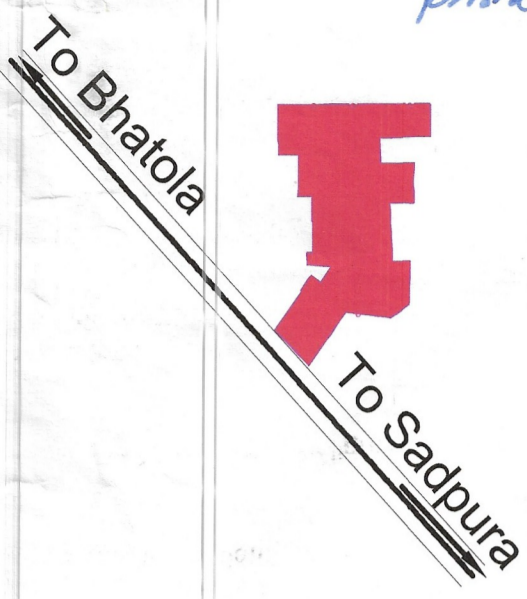

### DETAILS OF UNAUTHORIZED COLONY

Sr. No.	Parameter Name	Description	
1	Colony name	UNNAMED COLONY ID_7341	
2	Area	5.24 Acres	
3	Location of the colony	On Bhatola-Sadpura road. Near Satlok Ashram, Faridpur	
4	(i) Within MC	YES	
	(ii) Outside MC	NO	
4	Type of Colony and use (in %)	Residential 11.03% Industries 1.00%	
	Controlled Area	Controlled Area Around Old Faridabad East of Agra Canal Part-II	
6	Urban Area	FARIDABAD	
7	Year of establishment	2015	
8	Layout Plan (Scale)	1:1000	
9	Total Plots	NA	
10	Constructed Plots	38(R) +1 (I)= 39	
11	Number of vacant plots	NA	
12	Number of families residing in the colony	38	
13	Does the colony have electricity light?	Yes	
14	Does the colony have water supply through pipelines?	No	
15	Does the colony have underground sewerage facility?	No	
16	If connected to any external Sewage treatment plant? (Y/N)	No	
17	Does the colony have Park or Open space	No	
18	Road type on Colony	Kacha	
19	Different roads (in meters)	Road Width	Length (in mtrs)
		4.5 M	94.16 M
		5.0 M	385.49 M
		5.5 M	294.97 M
	8.5 M	250.74 M	
20	Minimum Road width	4.5 M	
21	Electricity provided to households through which sub station	FARIDPUR	
22	Area of the community site(in acres)	NO	
23	Is the RWA registered	No	
24	Additional Information, if any	NOTICE ISSUED	

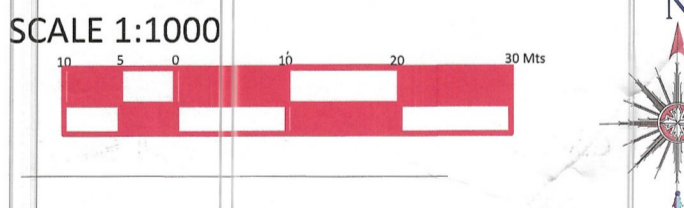

DRONE SURVEY AND LAYOUT PLAN PREPARED BY :-  
 PD CONSULTING ENGINEERS PVT.LTD



hello@pdcegroup.com www.pdcegroup.com  
 Red House, Behind MCD School,  
 Mehrauli-Gurgaon Rd, Ghitorni, Delhi - 30


Checked : PDCE Surveyor : RISHI PAL Sheet :- A0  
 Drawn By: AVINASH Sht. No. :- 1 OF 1 Rev. No.:-6818

DRG. NO. DTP(E)-FBD/2022/ DATED

LAYOUT PLAN CHECKED AND VERIFIED AT SITE BY :-

PATWARI \_\_\_\_\_  
 JUNIOR ENGG. \_\_\_\_\_  
 ASSISTANT TOWN PLANNER \_\_\_\_\_  
 DISTRICT TOWN PLANNER \_\_\_\_\_  
 SENIOR TOWN PLANNER \_\_\_\_\_

OFFICE-DISTRICT TOWN PLANNER(ENF), FARIDABAD  
 TOWN & COUNTRY PLANNING DEPTT., HARYANA

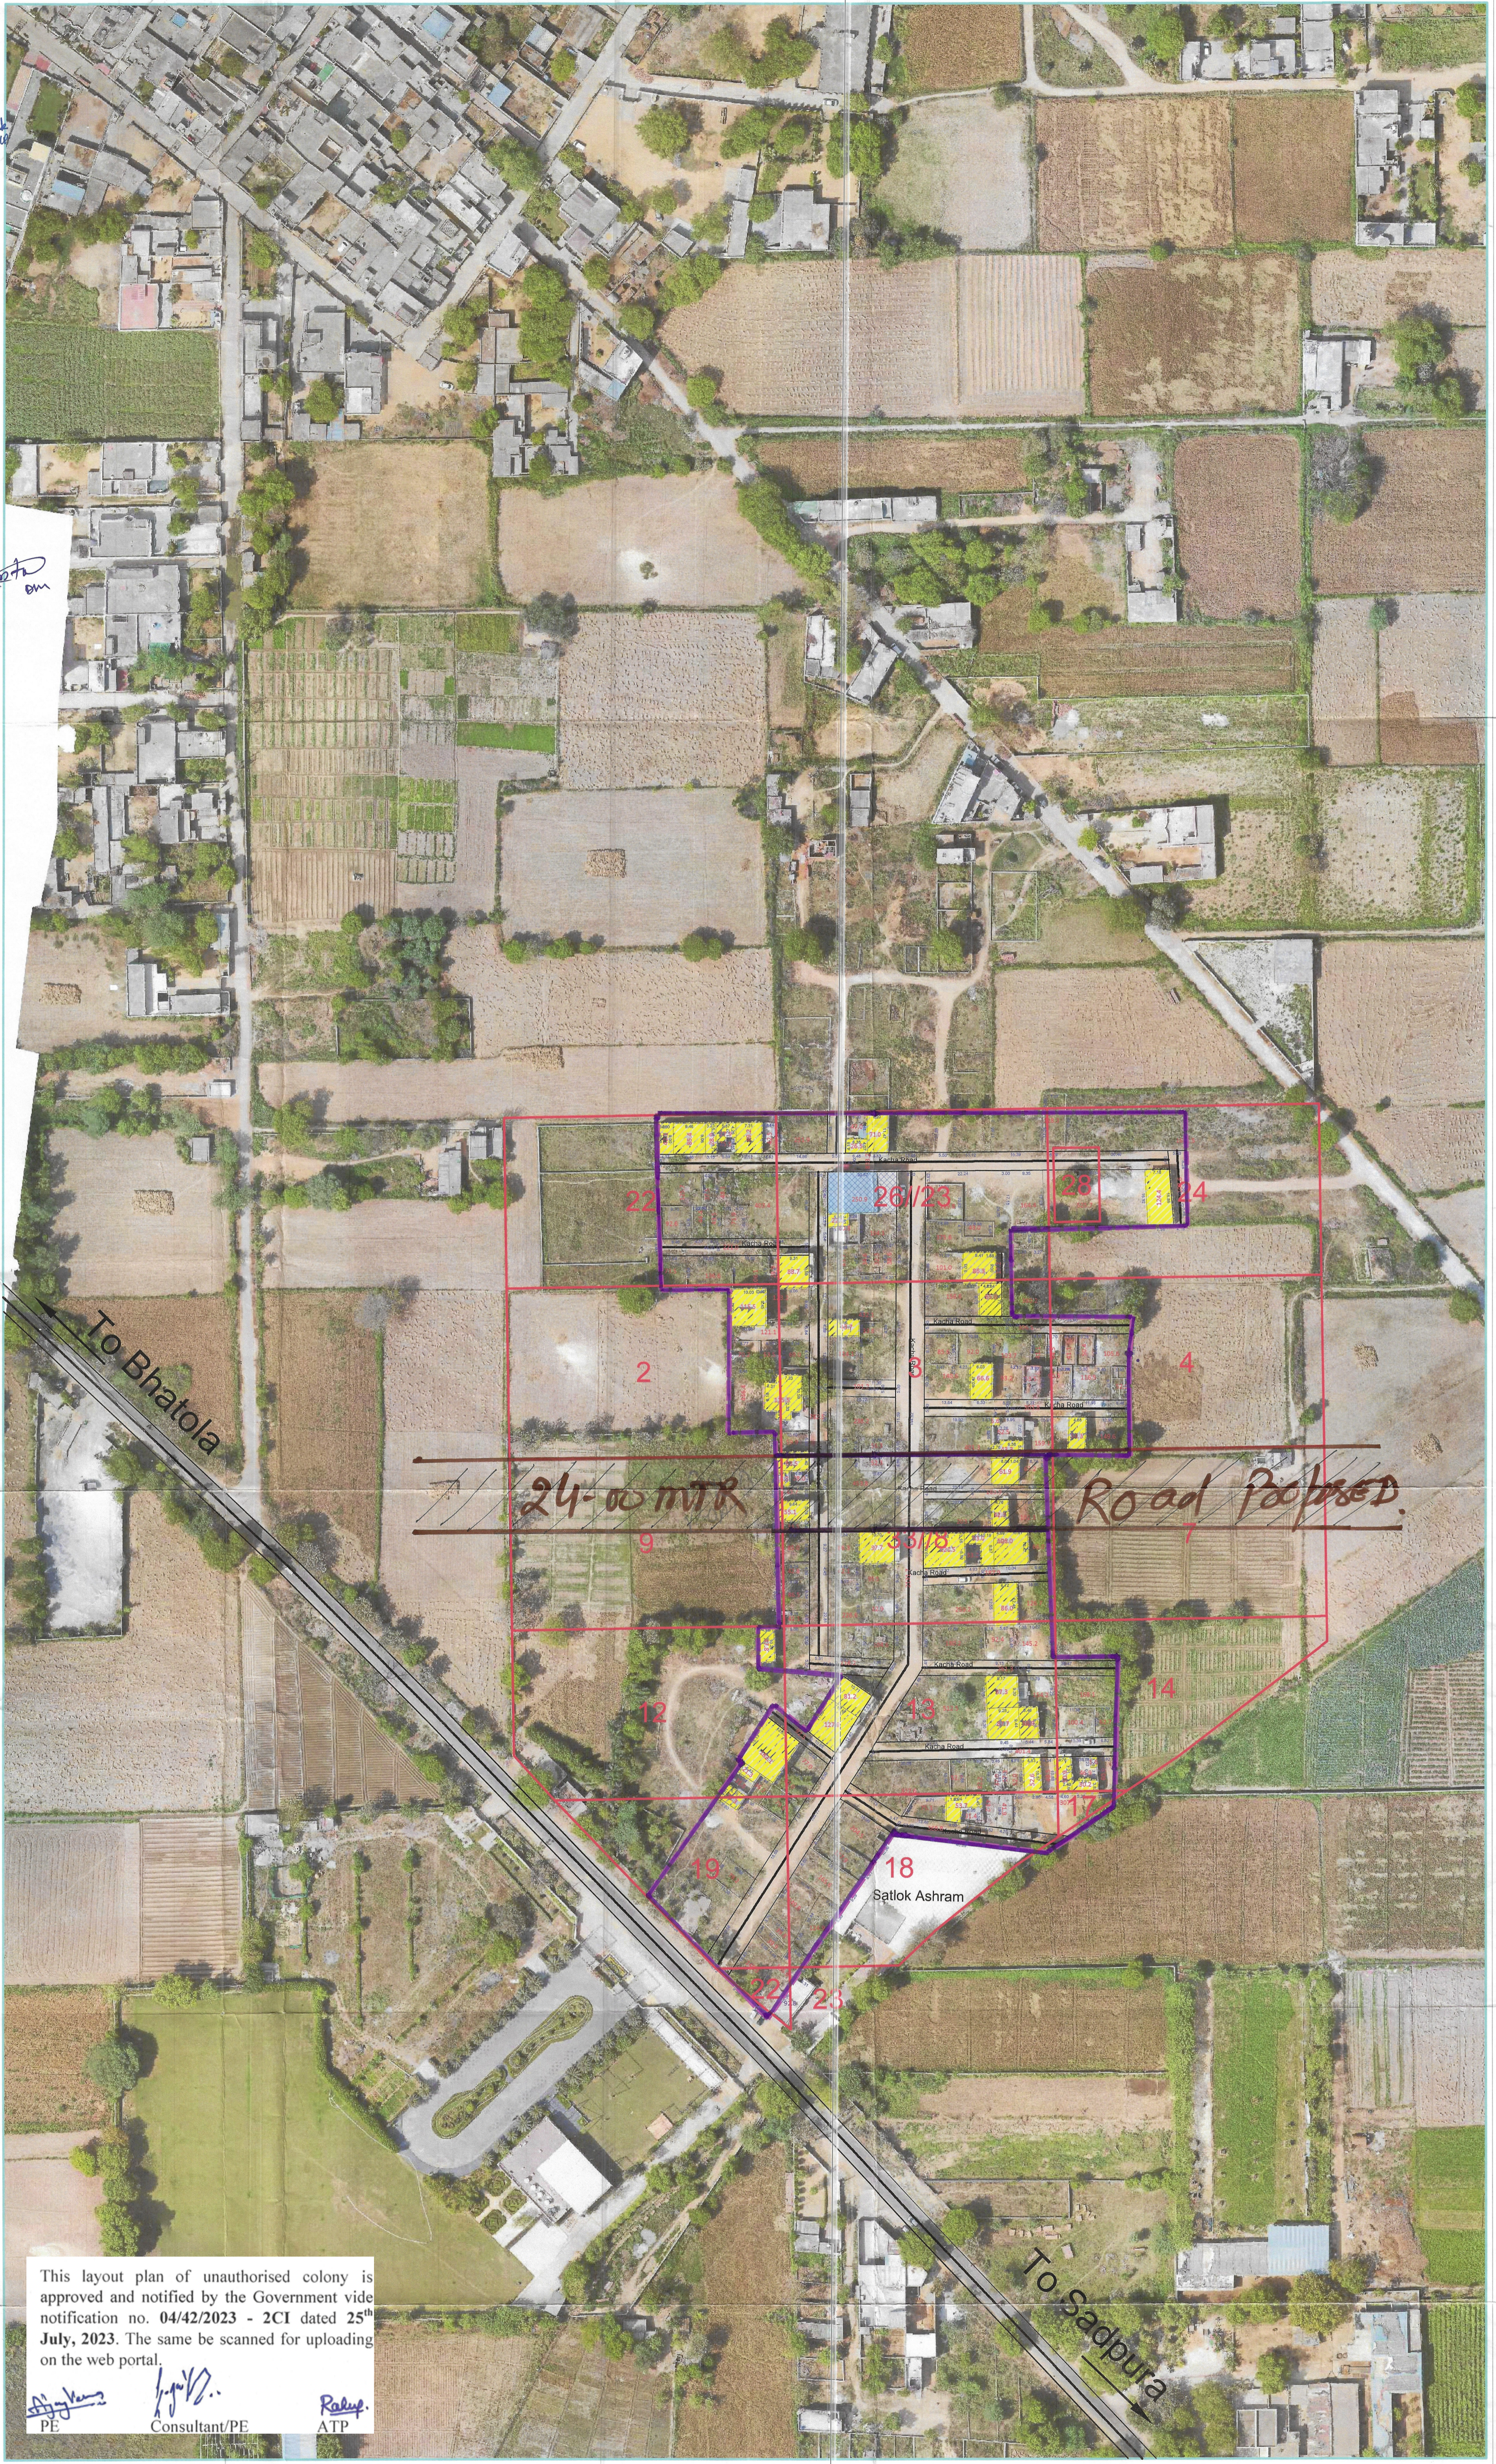

This layout plan of unauthorised colony is approved and notified by the Government vide notification no. 04/42/2023 - 2CI dated 25<sup>th</sup> July, 2023. The same be scanned for uploading on the web portal.

\_\_\_\_\_  
 PE Consultant/PE ATP

LEGEND		Murraba Line		Commercial Area		Parcel Num	
ManHole/ Chamber	TF/Electric/Mobile tower	Khasra Line	Built Up Area/Residential	Drain/Culvert / Bridge	Vacant Land	Industrial Area	
Street Light/Solar pole	Revenue Boundary	Colony Boundary	Vacant Plot (Not to be Regularised)	Kuccha Road			
City Road	Public & Semipublic Area	HT Line		Pucca Road			
		Sewerage Line		Divider Road			
		Water Supply Line		Temple/Mosque/Church/Flag Post			
		Vacant Plot (Not to be Regularised)		Statue/School/Airport/Hospital/Well			
				Tin Shed			

\_\_\_\_\_  
 Patwari

\_\_\_\_\_  
 Kanungo

\_\_\_\_\_  
 DM

\_\_\_\_\_  
 CTP

\_\_\_\_\_  
 Tehsildar

\_\_\_\_\_  
 DTP

\_\_\_\_\_  
 Div. CMC