


DISTRICT FARIDABAD

LAYOUT PLAN OF UNNAMED COLONY ID-9155 PART I IN THE REVENUE ESTATE OF VILLAGE - BHATOLA, TEHSIL-FARIDABAD, DISTRICT- FARIDABAD COMPRISING IN KHASRA NO. 18/25, 23/1/1, 9/2, 10/2, 11, 24/15, 6, 7/1, 14/2, 15, 16min.


KEY PLAN

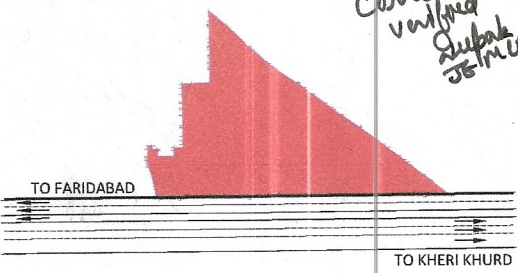

DETAILS OF UNAUTHORIZED COLONY

Sr. No.	Parameter Name	Description
1	Colony name	UNNAMED COLONY ID-9155 PART I
2	Area	8.57 Acres
3	Location of the colony	Near Bhatola Chowk
4	Colony and use (in %)	(i) Within MC
		Outside MC
5	Controlled Area	Residential
		Industrial
6	Urban Area	FARIDABAD
7	Year of establishment	NA
8	Layout Plan (Scale)	1:1000
9	Total Plots	NA
10	Constructed Plots(Residential-Industrial)	NA
11	Number of vacant plots	NA
12	Number of families residing in the colony	NA
13	Does the colony have street light?	No
14	Does the colony have water supply through pipelines?	No
15	Does the colony have underground sewerage facility?	No
16	If connected to any external Sewage treatment plant? (Y/N)	No
17	Does the colony have Park or Open space	NA
18	Road type on Colony (Kacha/Pucca)	Kacha/pukka
18	Width Of Different roads (in meters)	Road Width
		Length (in meters)
19	Minimum Road width	NA
20	Electricity provided to households through which sub station	NA
21	Does the colony have community site	No
22	Area of the community site(in acres)	Nil
23	Is the RWA registered	NA
24	Additional Information, if any	

No Notice issued, and found as a Village Extension. May be Considered for Omission from Geportal

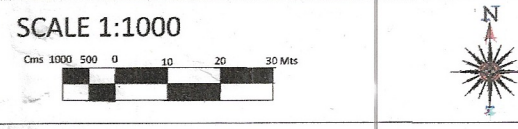

DRONE SURVEY AND LAYOUT PLAN PREPARED BY:- PD CONSULTING ENGINEERS PVT.LTD

PDCE GROUP
TRANSFORMING QUALITY & BUDGET
hello@pdcegroup.com, pdcegroup.com
Red House, Behind MCD School, Mehrauli-Gurgaon Rd, Ghitorni, Delhi - 30

Checked: PDCE Surveyor: RISHI PAL Sheet: A1
Drawn By: NAYAB Sht. No.: 1 OF 1 ID-9155_J

NOTE: ALL DIMENSIONS ARE IN METERS AND AREA IN ACRES.

DRG. NO. DTP(E)-FBD/2022/ DATED

LAYOUT PLAN CHECKED AND VERIFIED AT SITE BY:- PATWARI

JUNIOR ENGG. [Signature]
ASSISTANT TOWN PLANNER [Signature]
DISTRICT TOWN PLANNER [Signature]
SENIOR TOWN PLANNER

OFFICE-DISTRICT TOWN PLANNER(ENF), FARIDABAD TOWN & COUNTRY PLANNING DEPTT., HARYANA

BHATOLA VILLAGE ABADI EXTENSION

Total Area = 8.57 Acres.
BUILTUP AREA => 5.16 Acres 60.21%
Road => 0.50 Acres
Vacant -> 2.91 33.48%



This layout plan of unauthorised colony is approved and notified by the Government vide notification no. 04/42/2023 - 2CI dated 25th July, 2023. The same be scanned for uploading on the web portal.
[Signatures]
PE Consultant/PE ATP

= 2042.96 sqm
0.50 Acres
Built - 20908.98 sqm
5.16 Acres

[Signatures]
PATWARI KANUGO SR. ARCH. D.M J.E DTP CTP CMC DIV.CMC

LEGEND		Commercial Area	Industrial Area	Divider Road
Manhole/ Chamber	Murraba Line	Built Up Area/Residential	Vacant Plot (Not to be Regularised)	Temple/Mosque/Church/Flag Post
TF/Electric/Mobile tower	Khasra Line	Vacant Land/Plot	Public & Semipublic Area	Stature/School/Airport/Hospital/Well
Street Light/Solar pole	Colony Boundary	Drain/Culvert / Bridge		Tin Shed
Revenue Boundary	HT Line	Kaccha Road		
City Road	Sewerage Line	Pacca Road		
	Water Supply Line			