


DISTRICT FARIDABAD

LAYOUT PLAN OF UNNAMED COLONY ID-3094, IN THE REVENUE ESTATE OF VILLAGE BASELWA, TEHSIL-FARIDABAD, DISTRICT- FARIDABAD, COMPRISING IN KHASRA NOS. 31/10,9,11


KEY PLAN

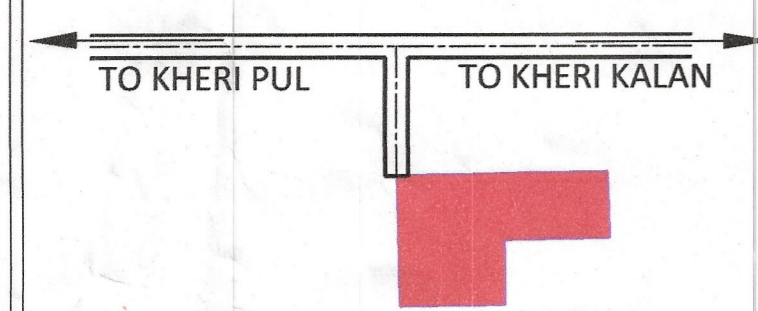

DETAILS OF UNAUTHORIZED COLONY

Sr. No.	Parameter Name	Description	
1	Colony name	UNNAMED COLONY (ID-3094)	
2	Area	3.00 Acres	
3	Location of the colony	NEAR RPS SAWAANA, BASELWA	
4	(i) Within MC	No	
	(ii) Outside MC	No	
4	Type of Colony and use (in %)	Residential 18.42 %	
5	Controlled Area	Controlled area around old Faridabad east of Agra canal part-3	
6	Urban Area	FARIDABAD	
7	Year of establishment	2019	
8	Layout Plan (Scale)	1:1000	
9	Total Plots	NA	
10	Constructed Plots (Residential)	41	
11	Number of vacant plots	NA	
12	Number of Families residing in the colony	41	
13	Does the colony have street light?	No	
14	Does the colony have water supply through pipelines?	No	
14	Does the colony have underground sewerage facility?	No	
15	If connected to any external Sewage treatment plant? (Y/N)	No	
16	Does the colony have Park or Open space	No	
17	Road type on Colony (Kacha/Pucca)	Kacha	
18	Width Of Different roads (in meters)	Road Width	Length (in meters)
		5.00M	94.2M
		5.50M	310.1M
		6.00M	149.52M
		6.50M	14.97M
19	Minimum Road width	5.0 M	
20	Electricity provided to households through which sub station	BASELWA	
21	Does the colony have community site	No	
22	Area of the community site (in acres)	NEI	
23	Is the RWA registered	NA	
24	Additional Information, if any	Notice issued	

SCALE 1:1000

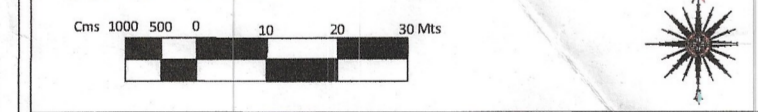

DRONE SURVEY AND LAYOUT PLAN PREPARED BY:- PD CONSULTING ENGINEERS PVT.LTD




Checked : PDCE Surveyor : RISHI PAL Sheet :- A/0
 Drawn By : NAYAB Sht. No. :- 1 OF 1 ID-3094

NOTE: ALL DIMENSIONS ARE IN METERS AND AREA IN ACRES

DRG. NO. DTP(E)-FBD/2022/ DATED

LAYOUT PLAN CHECKED AND VERIFIED AT SITE BY:- PATWARI

JUNIOR ENGG. [Signature]
 ASSISTANT TOWN PLANNER [Signature]
 DISTRICT TOWN PLANNER [Signature]
 SENIOR TOWN PLANNER [Signature]
 OFFICE-DISTRICT TOWN PLANNER(ENF), FARIDABAD TOWN & COUNTRY PLANNING DEPTT., HARYANA

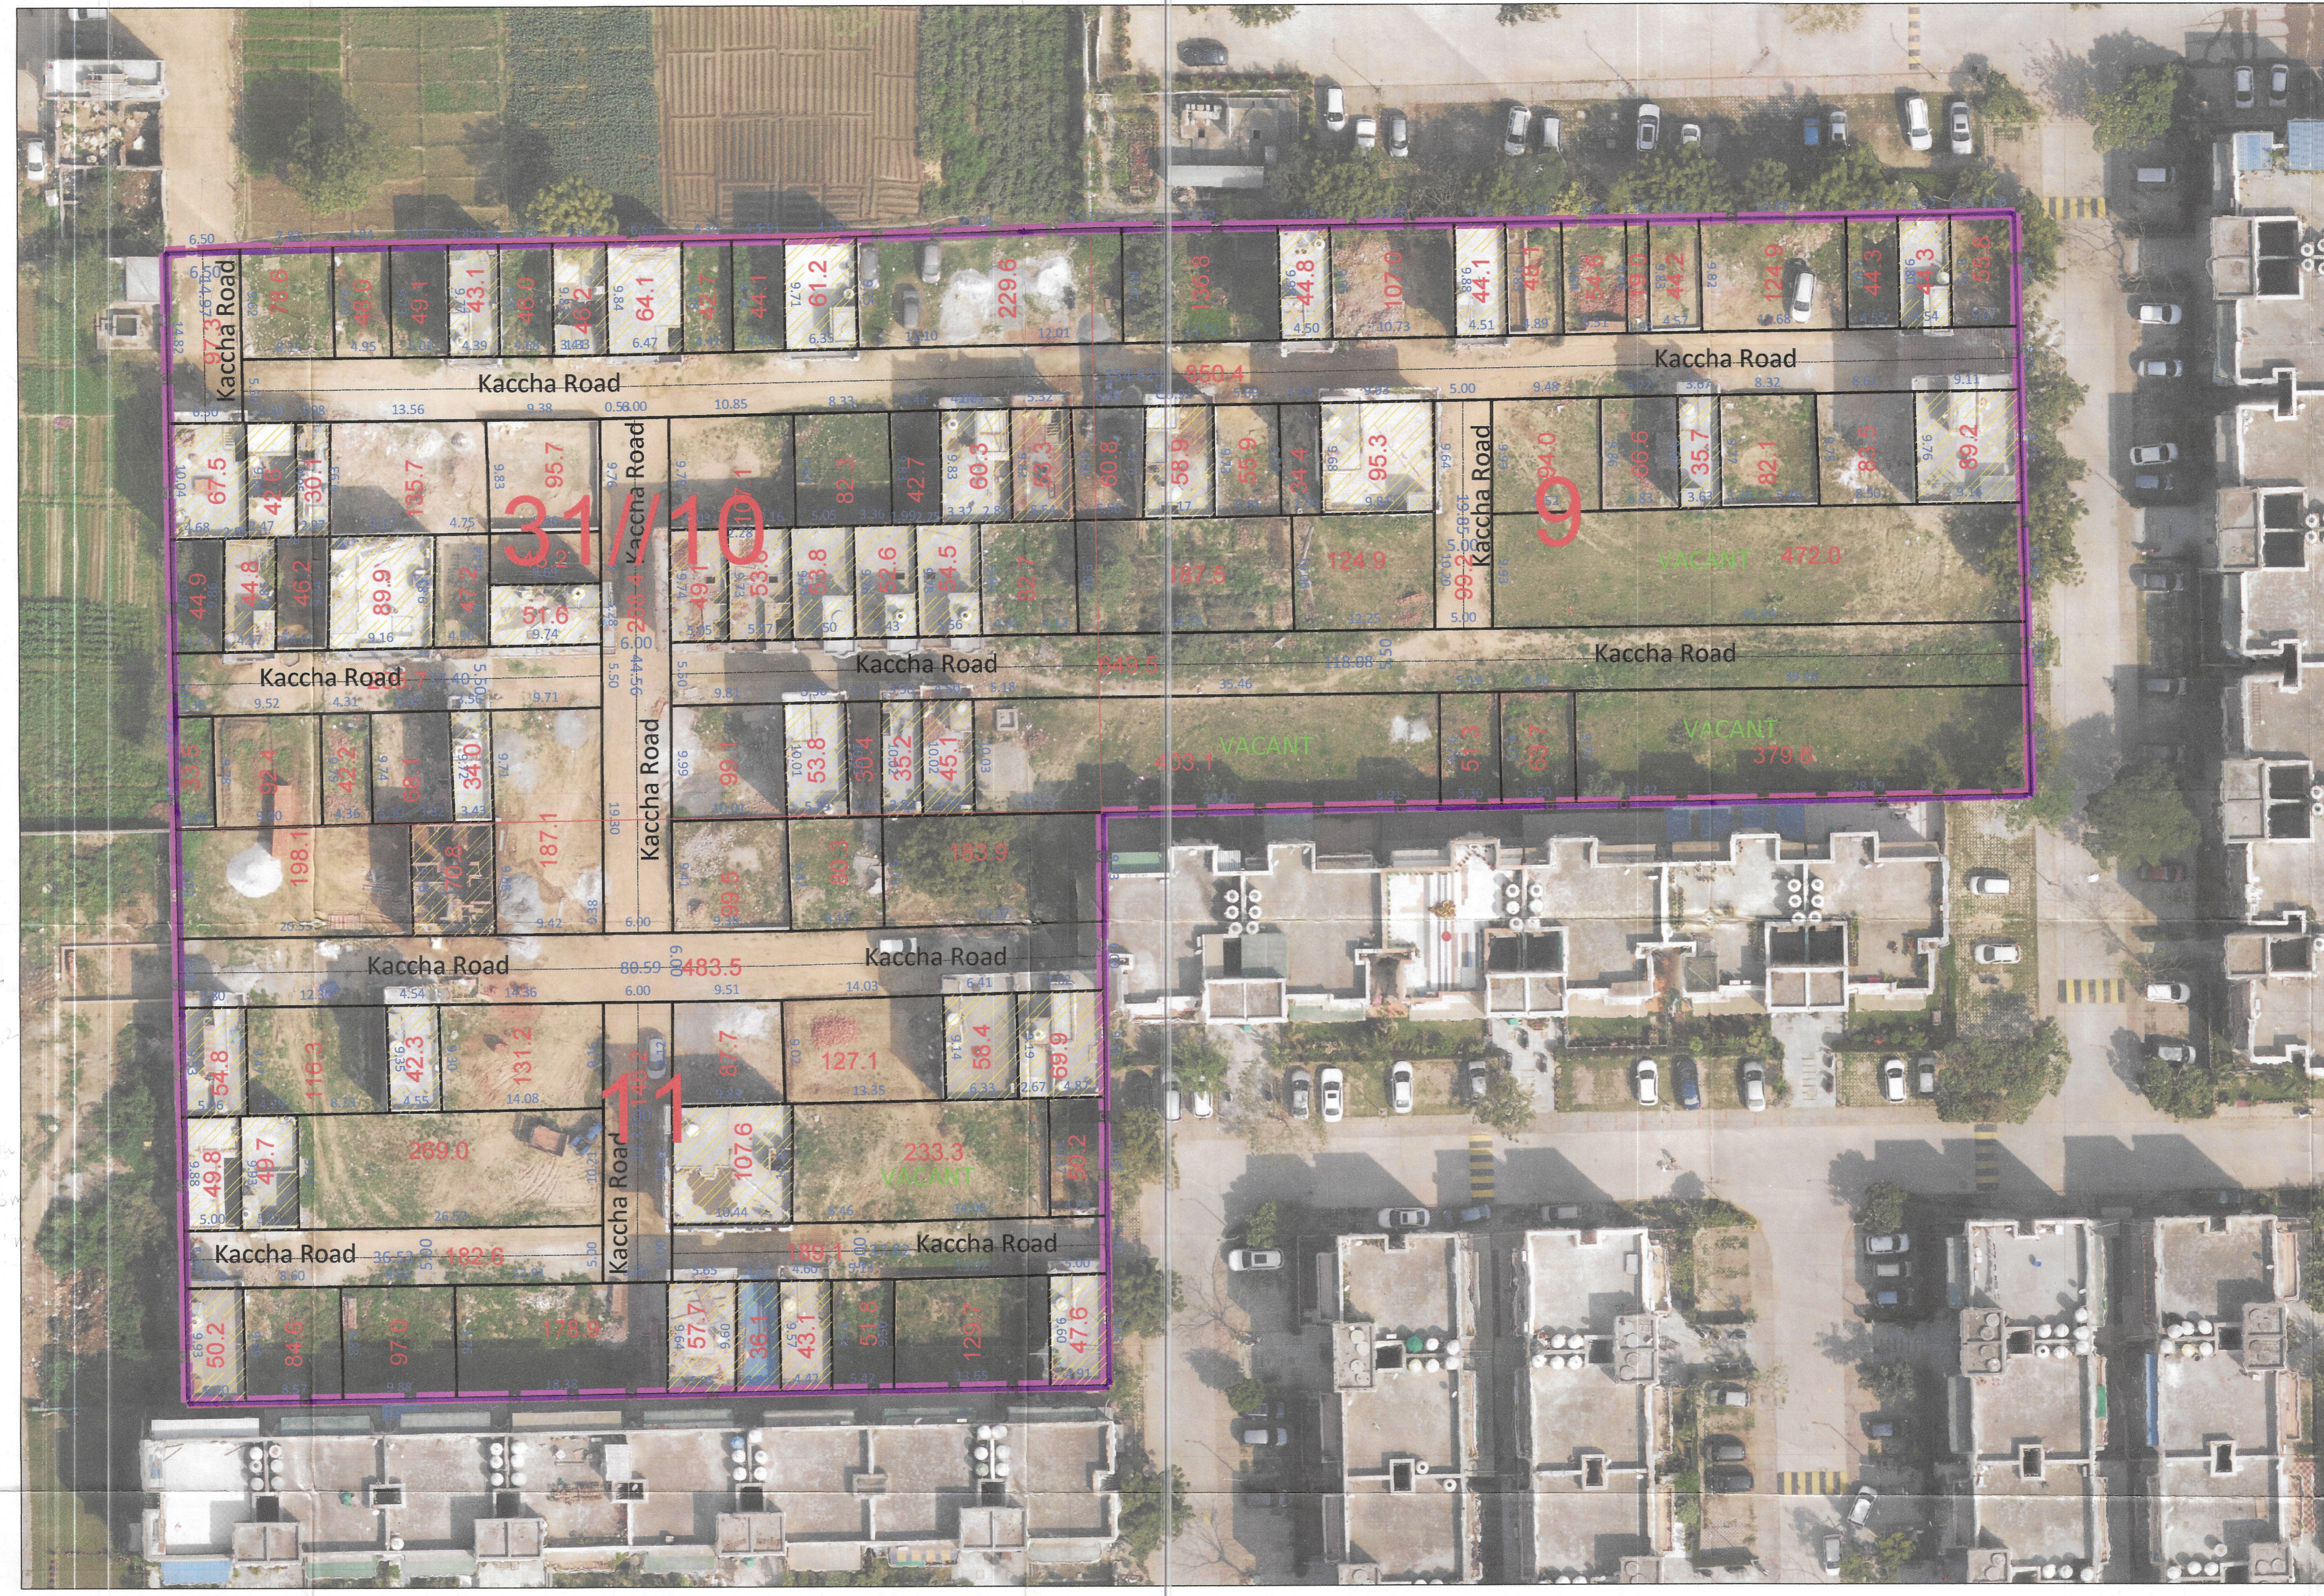

LEGEND		Commercial Area		Industrial Area		Divider Road	
Manhole/ Chamber		Murraba Line		Built Up Area/Residential		Temple/Mosque/Church/Flag Post	
TF/Electric/Mobile tower		Khasra Line		Vacant Plot (Not to be Regularised)		Statue/School/Airport/Hospital/Well	
Street Light/Solar pole		Colony Boundary		Public & Semipublic Area		Tin Shed	
Revenue Boundary		HT Line					
City Road		Sewerage Line					
		Water Supply Line					

This layout plan of unauthorised colony is approved and notified by the Government vide notification no. 04/42/2023 - 2CI dated 25th July, 2023. The same be scanned for uploading on the web portal.

[Signature] PE
 [Signature] Consultant/PE
 [Signature] ATP

[Signature] PA.
 [Signature] DTP ENF Faridabad

[Signature] PATWARI
 [Signature] ETP

[Signature] KANCOO
 [Signature] CMC

[Signature] TEHSILDAR
 [Signature] DIV CMC

[Signature] DIM
 [Signature] J-E
 [Signature] DTP