


SECTOR- 98. (Residential.)

DISTRICT FARIDABAD


LAYOUT PLAN OF UNNAMED COLONY ID-4413, IN THE REVENUE ESTATE OF VILLAGE-BHOPANI & NACHUALI, TEHSIL-FARIDABAD, DISTRICT-FARIDABAD, COMPRISING IN KHASRA NOS. BHOPANI-84/19/1, 20, 21, 22,1000.

KEY PLAN

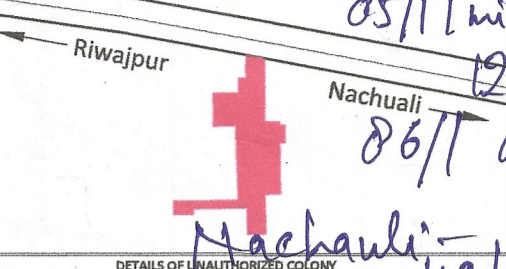

DETAILS OF UNAUTHORIZED COLONY

Sr. No.	Parameter Name	Description
1	Colony name	UNNAMED COLONY (ID-4413)
2	Area	6.08 Acres
3	Location of the colony	Near Vidya Sanskar School, Bhupani
4	Type of Colony and use (in %)	Residential 20.13 %
5	Controlled Area	Controlled Area Around Old Faridabad East of Agra Canal Part- II
6	Urban Area	FARIDABAD
7	Year of establishment	2014
8	Layout Plan (Scale)	1:1000
9	Total Plots	NA
10	Constructed Plots (Residential)	45
11	Number of vacant plots	NA
12	Number of families residing in the colony	45
13	Does the colony have street light?	No
14	Does the colony have water supply through pipelines?	No
15	Does the colony have underground sewerage facility?	No
16	If connected to any external Sewage treatment plant? (Y/N)	No
17	Does the colony have Park or Open space	No
18	Road type on Colony (kacha/pucca)	Kacha
19	Width Of Different roads (in meters)	Road Width Length (in mtrs) 6.0 M 904.32 M 5.0 M 142.87 M
20	Minimum Road width	5.0 M
21	Electricity provided to households through which sub station	KHERI KALAN SUB-STATION
22	Does the colony have community site	No
23	Area of the community site (in acres)	Nil
24	Is the RWA registered	NA
25	Additional information, if any	Notices issued

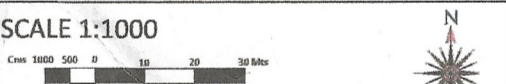

DRONE SURVEY AND LAYOUT PLAN PREPARED BY:-  
PD CONSULTING ENGINEERS PVT.LTD  
hello@pdcegroup.com  
Red House, Behind MCD School, Mehrauli-Gurgaon Rd, Ghitorni, Delhi - 30

Checked: PDCE Surveyor: RISHI PAL Sheet: A0  
Drawn By: NAYAB SHL No.:- 1 OF 1 ID-4413

DRG. NO. DTP(E)-FBD/2022/ DATED

LAYOUT PLAN CHECKED AND VERIFIED AT SITE BY:-  
PATWARI

JUNIOR ENGG.

ASSISTANT TOWN PLANNER

DISTRICT TOWN PLANNER

SENIOR TOWN PLANNER

OFFICE-DISTRICT TOWN PLANNER(ENF), FARIDABAD TOWN & COUNTRY PLANNING DEPTT., HARYANA



TOTAL AREA OF COLONY = 6.08 ACRES  
AREA UNDER PROPOSED ROAD = 0.32 ACRES  
BALANCE AREA OF COLONY = 5.76 ACRES

TEHSILDAR: KANBOGO  
PATWARI: Jyoti K  
DTP: DTP  
JE: Deepak JE  
CTP: CTP  
CMC: CMC  
DIV. CMC: DIV. CMC

Kh. No.:- Bhopani 84/19/1, 20, 21, 22,100  
Nachuali:- 82/12 min, 13 min, 14 min,min  
Total Area of site 6.08 Acres

This layout plan of unauthorised colony is approved and notified by the Government vide notification no. 04/42/2023 - 2CI dated 25<sup>th</sup> July, 2023. The same be scanned for uploading on the web portal.

<b>LEGEND</b>	Murraba Line	Commercial Area	Industrial Area
Manhole/ Chamber	Khasra Line	Built Up Area/Residential	Vacant Plot ( Not to be Regularised)
TF/Electric/Mobile tower	Colony Boundary	Vacant Land/Plot	Divider Road
Street Light/Solar pole	HT Line	Drain/Culvert / Bridge	Temple/Mosque/Church/Flag Post
Revenue Boundary	Sewerage Line	Kaccha Road	Statue/School/Airport/Hospital/Well
City Road	Water Supply Line	Pucca Road	Tin Shed