


DISTRICT FARIDABAD

LAYOUT PLAN OF UNNAMED COLONY ID-4607 IN THE REVENUE ESTATE OF VILLAGE GAUNCHI TEHSIL-GAUNCHI, DISTRICT-FARIDABAD COMPRISING IN KHASRA NO. 113//S.19min 17.7m, 18m


SEC FOR-56 Faridabad.
Connection verified
Rh. No - 113//17m, 18m, 19m

KEY PLAN

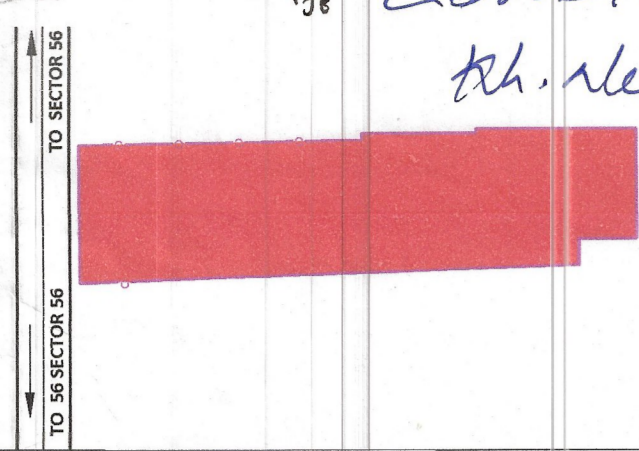

DETAILS OF UNAUTHORIZED COLONY

Sr. No.	Parameter Name	Description
1	Colony name	UNNAMED COLONY(D-4607)
2	Area	2.58 Acres ✓ <i>2.455</i>
3	Location of the colony	IN SECTOR 56 FARIDABAD
4	(i) Within MC	Yes
	(ii) Outside MC	No
4	Type of Colony and use (in %)	Residential 20.91%
5	Controlled Area	Additional controlled area around Faridabad Balaogh Complex
6	Urban Area	FARIDABAD
7	Year of establishment	2014
8	Layout Plan (Scale)	1:1000
9	Total Plots	NA
10	Constructed Plots(Residential+Industrial+com)	29(9)
11	Number of vacant plots	NA
12	Number of families residing in the colony	29
13	Does the colony have street light?	YES
14	Does the colony have water supply through pipelines?	No
15	Does the colony have underground sewerage facility?	No
16	If connected to any external Sewage treatment plant? (Y/N)	No
17	Does the colony have Park or Open space	NA
18	Road type on Colony (kacha/pucca)	kacha
18	Width of different roads (in meters)	Road Width 6.00M
		Length (in meters) 400.00M ✓
19	Minimum Road width	6.00M
20	Electricity provided to households through which sub station	NA
21	Does the colony have community site	No
22	Area of the community site(in acres)	Nil
23	Is the RWA registered	NA
24	Additional information, if any	NOTICE ISSUED

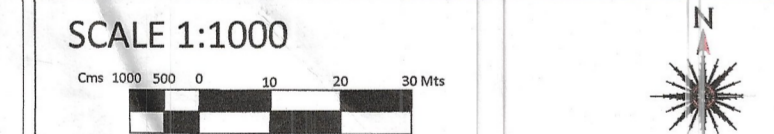

DRONE SURVEY AND LAYOUT PLAN PREPARED BY:- PD CONSULTING ENGINEERS PVT.LTD

PDCE GROUP
TRANSFORMING QUALITY & SKILLSET
hello@pdcegroup.com
www.pdcegroup.com
Red House, Behind MCD School,
Mehrauli-Gurgaon Rd, Ghitori, Delhi - 30

Checked: PDCE Surveyor: RISHI PAL Sheet: A1
Drawn By: SHUBHAM Sht. No.: 1 OF 1 ID-4607

NOTE:
ALL DIMENSIONS ARE IN METERS AND AREA IN ACRES
DRG. NO. DTP(E)-FBD/2022/ DATED

LAYOUT PLAN CHECKED AND VERIFIED AT SITE BY:-
PATWARI

JUNIOR ENGG. *[Signature]*
ASSISTANT TOWN PLANNER *[Signature]*
DISTRICT TOWN PLANNER *[Signature]*
SENIOR TOWN PLANNER *[Signature]*
OFFICE-DISTRICT TOWN PLANNER(ENF), FARIDABAD TOWN & COUNTRY PLANNING DEPTT., HARYANA



*Note:- 18 metre green Belt
12 mtr. Service Road*

-160-
S. NO. 35

Revenue Deptt.
Patwari
Kandho
Tehsil Dar
DM
JE
DTP
CTP
CNC
Div. CNC

This layout plan of unauthorised colony is approved and notified by the Government vide notification no. 04/42/2023 - 2CI dated 25th July, 2023. The same be scanned for uploading on the web portal.
[Signature] PE
[Signature] Consultant/PE
[Signature] ATP

LEGEND							
Manhole/ Chamber		Murraba Line		Commercial Area		Industrial Area	
TF/Electric/Mobile tower		Khasra Line		Built Up Area/Residential		Vacant Plot (Not to be Regularised)	
Street Light/Solar pole		Colony Boundary		Vacant Land/Plot		Divider Road	
Revenue Boundary		HT Line		Drain/Culvert / Bridge		Temple/Mosque/Church/Flag Post	
City Road		Sewerage Line		Kaccha Road		Statue/School/Airport/Hospital/Well	
		Water Supply Line		Pacca Road		Tin Shed	