


DISTRICT FARIDABAD

LAYOUT PLAN OF UNNAMED COLONY ID-6206_1, IN THE REVENUE ESTATE OF VILLAGE-ATIMADPUR, TEHSIL-FARIDABAD DISTRICT-FARIDABAD COMPRISING IN KHASRA NOS. 19/11, 19/12, 19/13, 19/99, 19/100

KEY PLAN

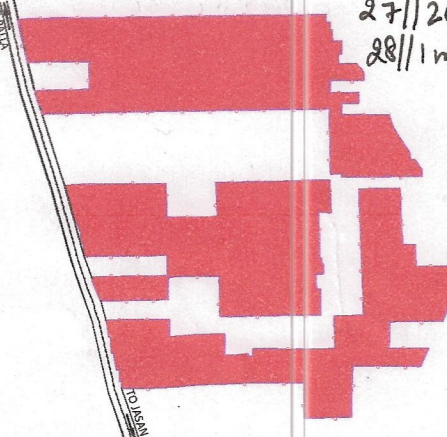

DETAILS OF UNAUTHORIZED COLONY

Sr. No.	Parameter Name	Description	
1	Colony name	UNNAMED COLONY (ID-6206_1)	
2	Area	42.22 Acres ✓	
3	Location of the colony	ON PALLA TO JASANA ROAD	
4	(i) Within MC	Yes	
	(ii) Outside MC	No	
4	Type of Colony and use (in %)	Residential 53.02%	
5	Controlled Area	CONTROLLED AREA AROUND MUNICIPAL TOWN OF FARIDABAD	
6	Urban Area	FARIDABAD	
7	Year of establishment	2000	
8	Layout Plan (Scale)	1:1000	
9	Total Plots	NA	
10	Constructed Plots (Residential)	295/91	
11	Number of vacant plots	NA	
12	Number of families residing in the colony	295	
13	Does the colony have street light?	No	
14	Does the colony have water supply through pipelines?	No	
15	Does the colony have underground sewerage facility?	YES	
15	If connected to any external Sewage treatment plant? (Y/N)	No	
16	Does the colony have Park or Open space	No	
17	Road type on Colony (bacha/pucca)	PUCCA ROAD	
18	Width of Different roads (in meters)	Road Width	Length (in mtrs)
		3.50M	236.75M
		4.00M	3297.93M
		4.50M	747.53M
		5.00M	2065.78M
		5.50M	1636.64M
		6.00M	1390.25M
7.00M	144.33M		
19	Minimum Road width	3.50M	
20	Electricity provided to households through which sub station	YES	
21	Does the colony have community site	No	
22	Area of the community site (in acres)	Nil	
23	Is the NWA registered	NA	
24	Additional information, if any	NOTICE ISSUED.	


SCALE 1:1000
Cms 0 500 1000 1500 2000

DRONE SURVEY AND LAYOUT PLAN PREPARED BY:-
PD CONSULTING ENGINEERS PVT.LTD
PDCE GROUP
TRANSFORMING QUALITY & BUDGET
hello@pdcegroup.com
Red House, Behind MCD School,
Mehrauli-Gurgaon Rd, Ghitomi, Delhi - 30

Checked: PDCE Surveyor: RISHI PAL Sheet: A0
Drawn By: NAYAB Sht. No. :- 1_OF_1 ID-6206_1
NOTE:
ALL DIMENSIONS ARE IN METERS AND AREA IN ACRES.

DRG. NO. DTP(E)-FBD/2022/ DATED _____
LAYOUT PLAN CHECKED AND VERIFIED AT SITE BY:-
PATWARI

JUNIOR ENGG. [Signature]
ASSISTANT TOWN PLANNER [Signature]
DISTRICT TOWN PLANNER [Signature]
SENIOR TOWN PLANNER [Signature]
OFFICE-DISTRICT TOWN PLANNER(ENF), FARIDABAD
TOWN & COUNTRY PLANNING DEPTT., HARYANA

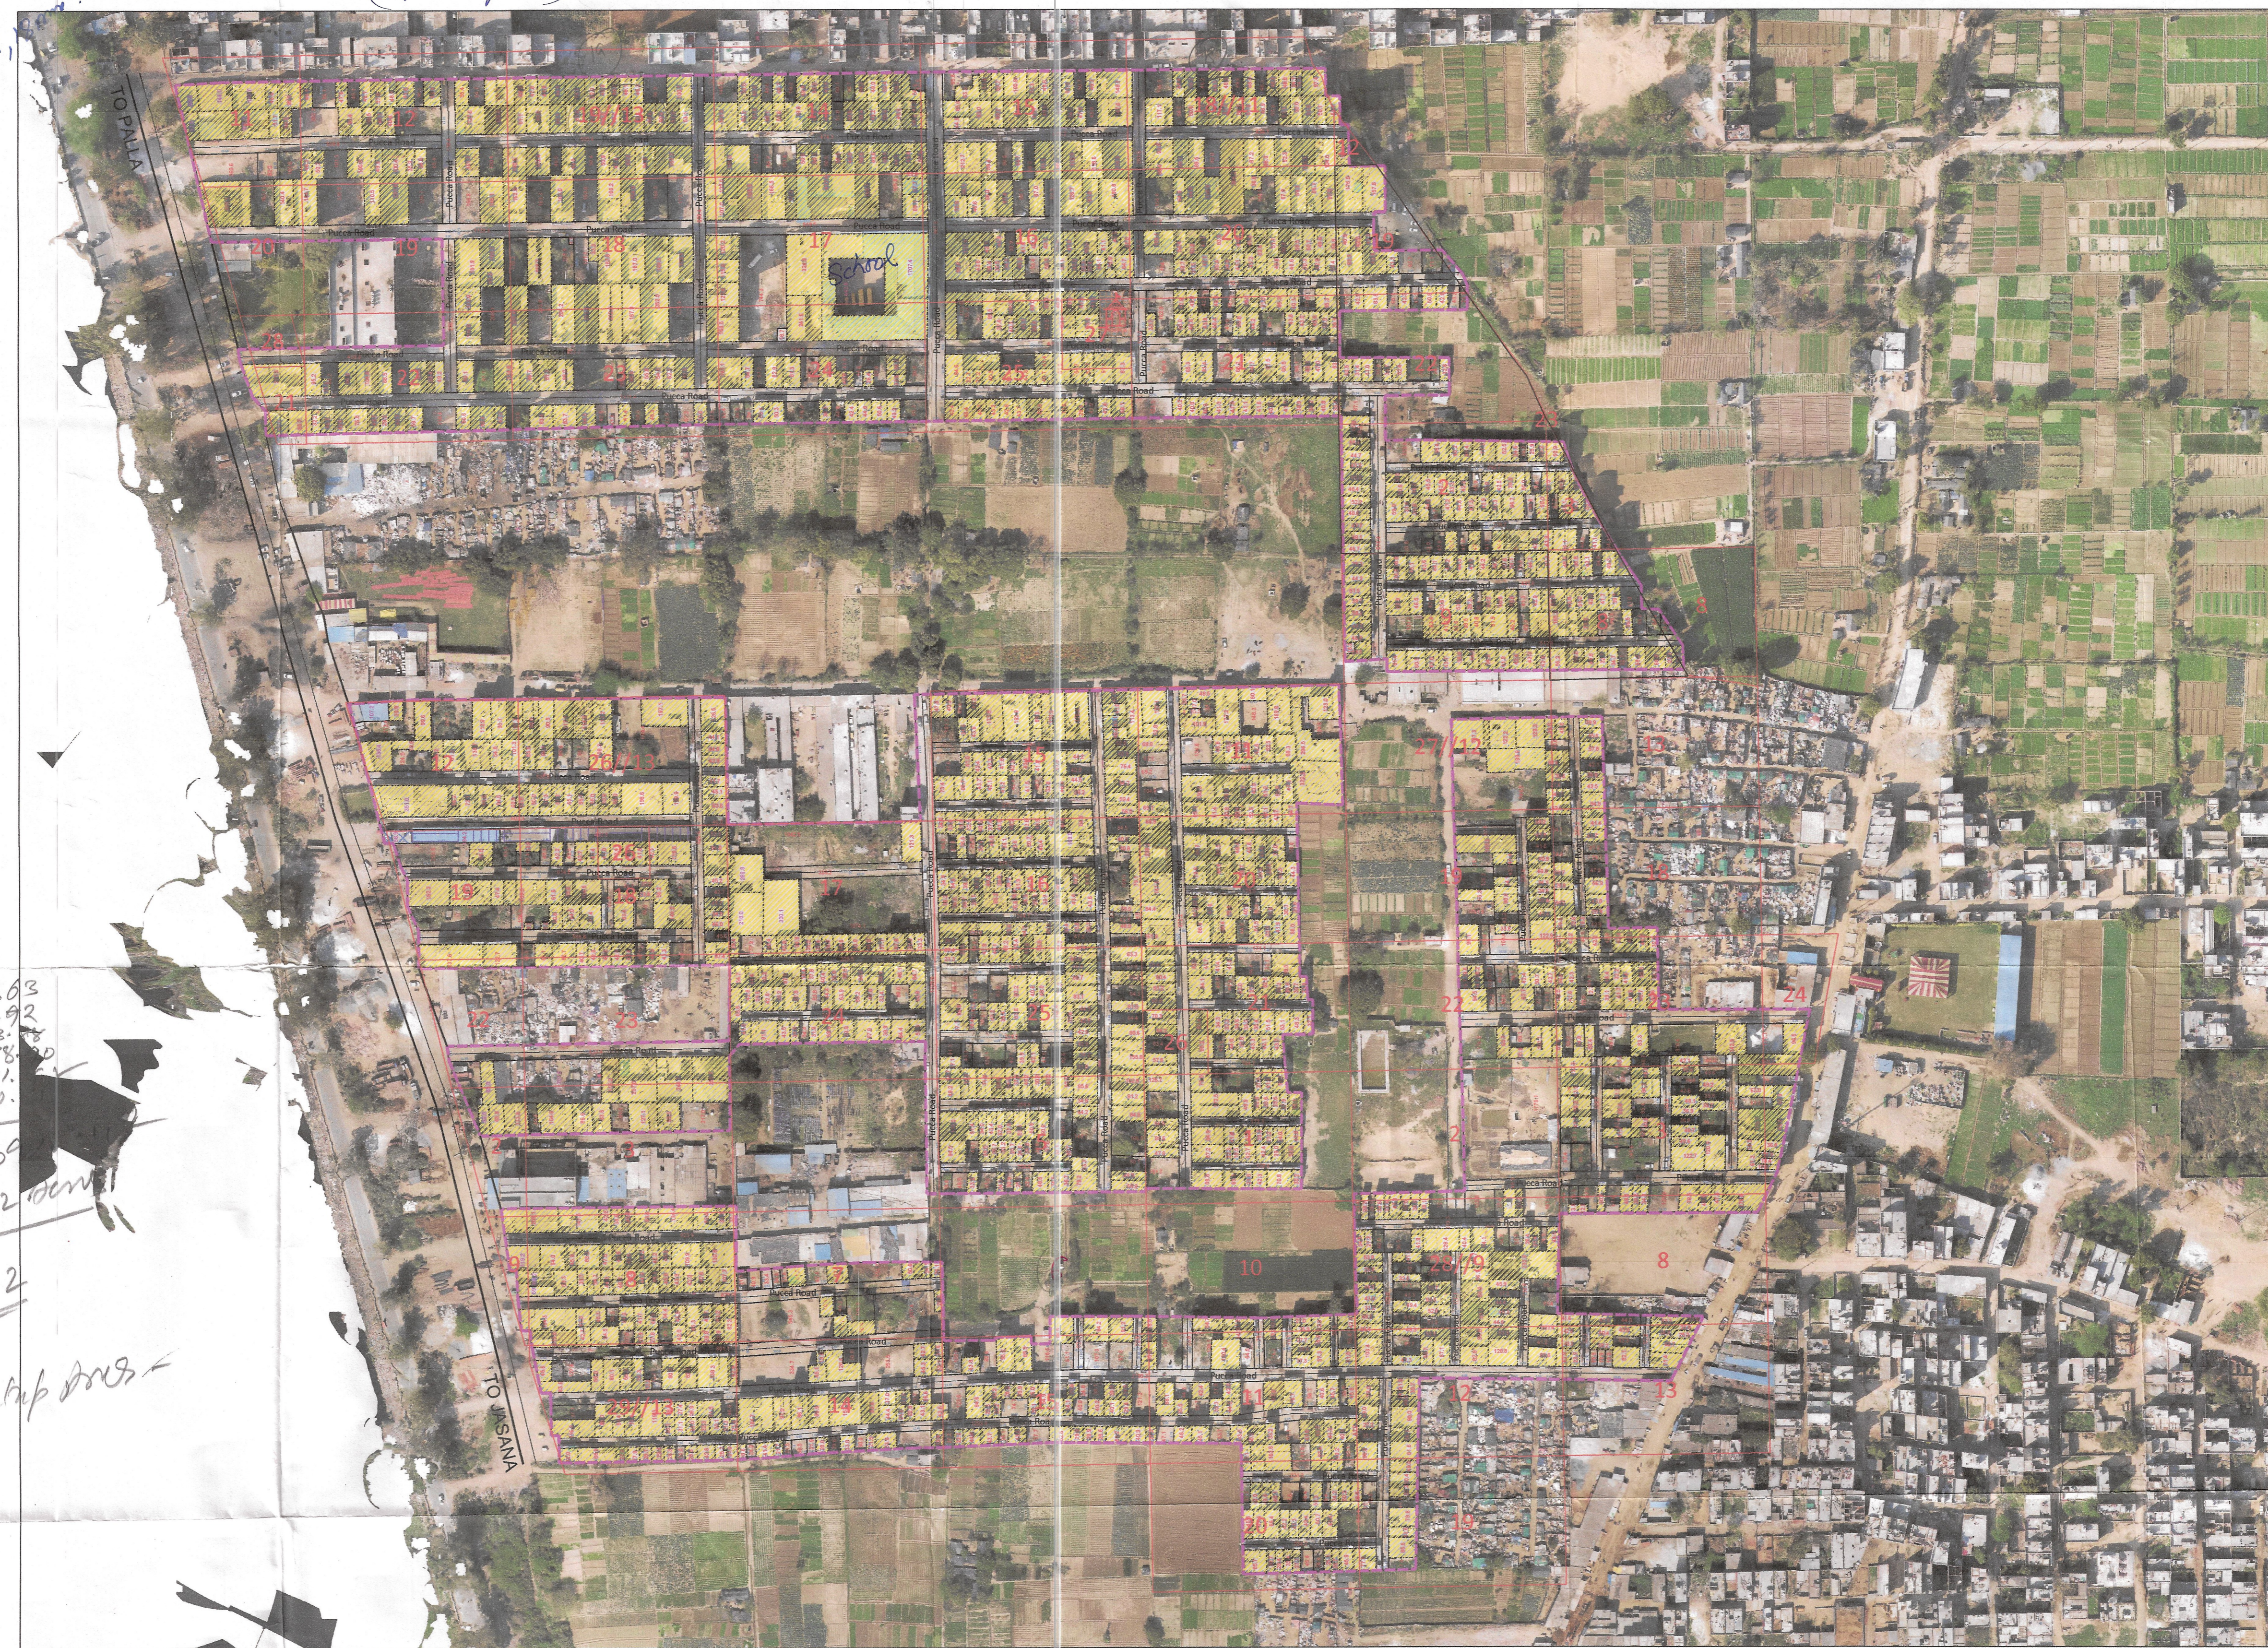

828.63
519.92
336.88
1038.80
8341.
1010.
2439
5.02
36.2
Built up Area

SECTOR - null (Open Space)

LEGEND							
Manhole/ Chamber		Murraba Line		Commercial Area		Industrial Area	
TF/Electric/Mobile tower		Khasra Line		Built Up Area/Residential		Vacant Plot (Not to be Regularised)	
Street Light/Solar pole		Colony Boundary		Vacant Land/Plot		Divider Road	
Revenue Boundary		HT Line		Drain/Culvert / Bridge		Temple/Mosque/Church/Flag Post	
City Road		Sewerage Line		Kaccha Road		Statue/School/Airport/Hospital/Well	
		Water Supply Line		Pacca Road		Tin Shed	

Kh. No. 19/11 min, 12 min, 13 min,
14 min, 15 min, 16, 17, 18, 19 min
20 min, 21 min, 22 min, 23 min
24 min, 25 min, 26
19/11 min, 12 min, 13 min, 14,
15 min, 22 min, 23 min, 24 min, 25 min, 26 min,
Total Area = 42.22
Acres
CORRECTION VERIFIED

[Signatures]
PATWARI
KANOOGO
TEHSILDAR
DM
JE
DTP
CTP
CIC
D.V. C.M.C.