



DISTRICT FARIDABAD

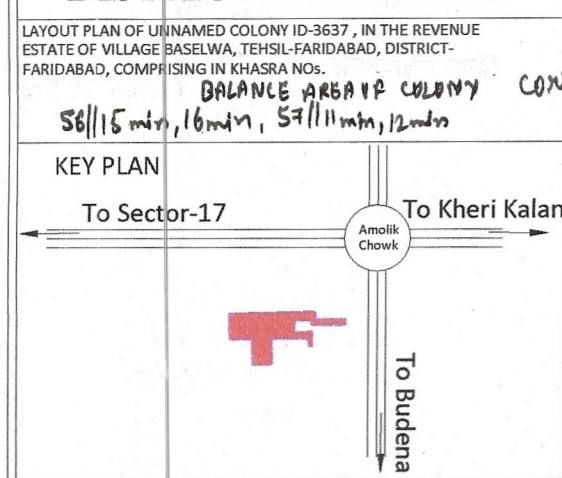

Sr. No.	Parameter Name	Description	
1	Colony name	UNNAMED COLONY (ID-3637)	
2	Area of Colony	2.307 Acres	
3	Location of the colony	Near Amolik Chowk, Sector-86, Faridabad	
4	(i) Within MC	Yes	
	(ii) Outside MC	No	
4	Type of Colony and use (in %)	Residential 100%	
5	Controlled Area	Controlled area around old Faridabad east of Agra canal part-1	
6	Urban Area	FARIDABAD	
7	Year of establishment	2016	
8	Layout Plan (Scale)	1:1000	
9	Total Plots	NA	
10	Constructed Plots (Residential)	54	
11	Number of vacant plots	NA	
12	Number of families residing in the colony	54	
13	Does the colony have street light?	No	
14	Does the colony have water supply through pipelines?	No	
14	Does the colony have underground sewerage facility?	No	
15	If connected to any external Sewage treatment plant? (Y/N)	No	
16	Does the colony have Park or Open space	No	
17	Road type on Colony (Kacha/pucca)	Kacha	
18	Width Of Different roads (in meters)	Road Width	Length (in mtrs)
		4.50 M	47.60 M
		5.00 M	110.46 M
		5.50 M	243.22 M
		6.00M	135.79 M
19	Minimum Road width	4.50 M	
20	Electricity provided to households through which sub station	Sector-15, Baselwa	
21	Does the colony have community site	No	
22	Area of the community site (in acres)	Nil	
23	Is the RWA registered	NA	
24	Additional Information, if any	Notices issued	

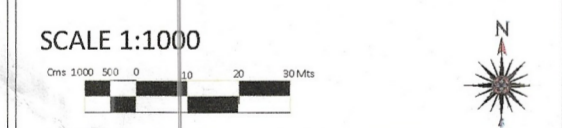

DRONE SURVEY AND LAYOUT PLAN PREPARED BY:-
PD CONSULTING ENGINEERS PVT.LTD

PDCE GROUP
 TRANSFORMING QUALITY & BUDGET
 hello@pdcegroup.com
 Red House, Behind MCD School,
 Mehrauli-Gurgaon Rd, Ghitorni, Delhi - 30

Checked: PDCE Surveyor: RISHI PAL Sheet: A0
 Drawn By: NAYAB Sht. No.: 1 OF 1 ID-3637

NOTE:
 ALL DIMENSIONS ARE IN METERS AND AREA IN ACRES.

DRG. NO. DTP(E)-FBD/2022/ DATED

LAYOUT PLAN CHECKED AND VERIFIED AT SITE BY:-
 PATWARI

JUNIOR ENGG. [Signature]
 ASSISTANT TOWN PLANNER [Signature]
 DISTRICT TOWN PLANNER (E) [Signature]
 SENIOR TOWN PLANNER [Signature]
 OFFICE-DISTRICT TOWN PLANNER(ENF), FARIDABAD
 TOWN & COUNTRY PLANNING DEPTT., HARYANA

SECTOR- 86, Village- Baselwa
 Note:- 108.13 Sgm. (0.263 Acres) facing road 18mtr wide prepared Road.

consulting verified. Detail 25 mtr



Connection Needed as per 18 mtr prepared Road.

36-8115
 Road length 401.2
 6m x 9m x 13m
 12m x 6m

This layout plan of unauthorised colony is approved and notified by the Government vide notification no. 04/42/2023 - 2CI dated 25th July, 2023. The same be scanned for uploading on the web portal.

PE [Signature] Consultant/PE [Signature] ATP [Signature]

PATWARI [Signature] KANUGO [Signature] SR. ARCH. [Signature] D.M. [Signature] J.E. [Signature] DTP [Signature] CTP [Signature] CMC [Signature] DIV.CMC [Signature]

LEGEND							
Murraba Line		Commercial Area		Industrial Area		Divider Road	
Manhole/ Chamber		Khasra Line		Built Up Area/Residential		Vacant Plot (Not to be Regularised)	
TF/Electric/Mobile tower		Colony Boundary		Vacant Land/Plot		Temple/Mosque/Church/Flag Post	
Street Light/Solar pole		HT Line		Drain/Culvert / Bridge		Statue/School/Airport/Hospital/Well	
Revenue Boundary		Sewerage Line		Kaccha Road		Public & Semipublic Area	
City Road		Water Supply Line		Pacca Road		Tin Shed	