




DISTRICT FARIDABAD

NOTE AREA PROPOSED FOR NOTIFICATION IS NOT COVERED UNDER NCZ.

LAYOUT PLAN OF UNNAMED COLONY ID-3343 IN THE REVENUE ESTATE OF VILLAGE CHANDRAWLI, TEHSIL-FARIDABAD, DISTRICT-FARIDABAD COMPRISING IN KHASRA NO. 15/4min,5min,6min,7min 16/1min,10min

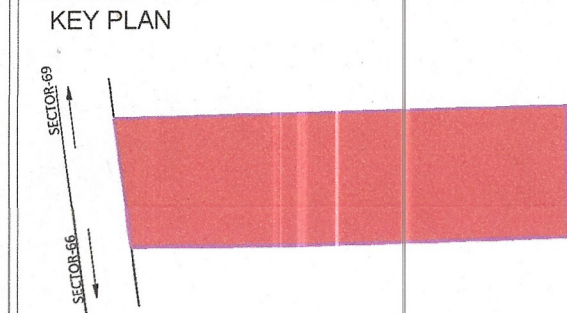

DETAILS OF UNAUTHORIZED COLONY		
Sr. No.	Parameter Name	Description
1	Colony name	UNNAMED COLONY ID-3343
2	Area	2.41 Acres
3	Location of the colony	NEAR FMDA
4	(i) Within MC	Yes
	Outside MC	No
5	Use of Colony and use (in %)	Residential
		Commercial
6	Controlled Area	Additional controlled area around Faridabad Complex Administration
7	Urban Area	FARIDABAD
8	Year of establishment	2016
9	Layout Plan (Scale)	1:1000
10	Total Plots	NA
11	BUILT UP AREA	1.17 ACRE i.e 68.82 %
12	VACANT AREA IN %	31.17 %
13	Number of families residing in the colony	54
14	Does the colony have street light?	Yes
15	Does the colony have water supply through pipelines?	No
16	Does the colony have underground sewerage facility?	No
17	If connected to any external Sewage treatment plant? (Y/N)	No
18	Does the colony have Park or Open space	NA
19	Road type on Colony (kacha/pacca)	PACCA
20	Width Of Different roads (in meters)	Road Width
		Length (in mtrs)
21	Minimum Road width	5.00M
22	Electricity provided to households through high sub station	NA
23	Does the colony have community site	No
24	Area of the community site(in acres)	Nil
25	Is the RWA registered	NA
26	Additional information, if any	NOTICE ISSUED

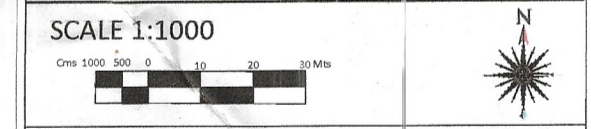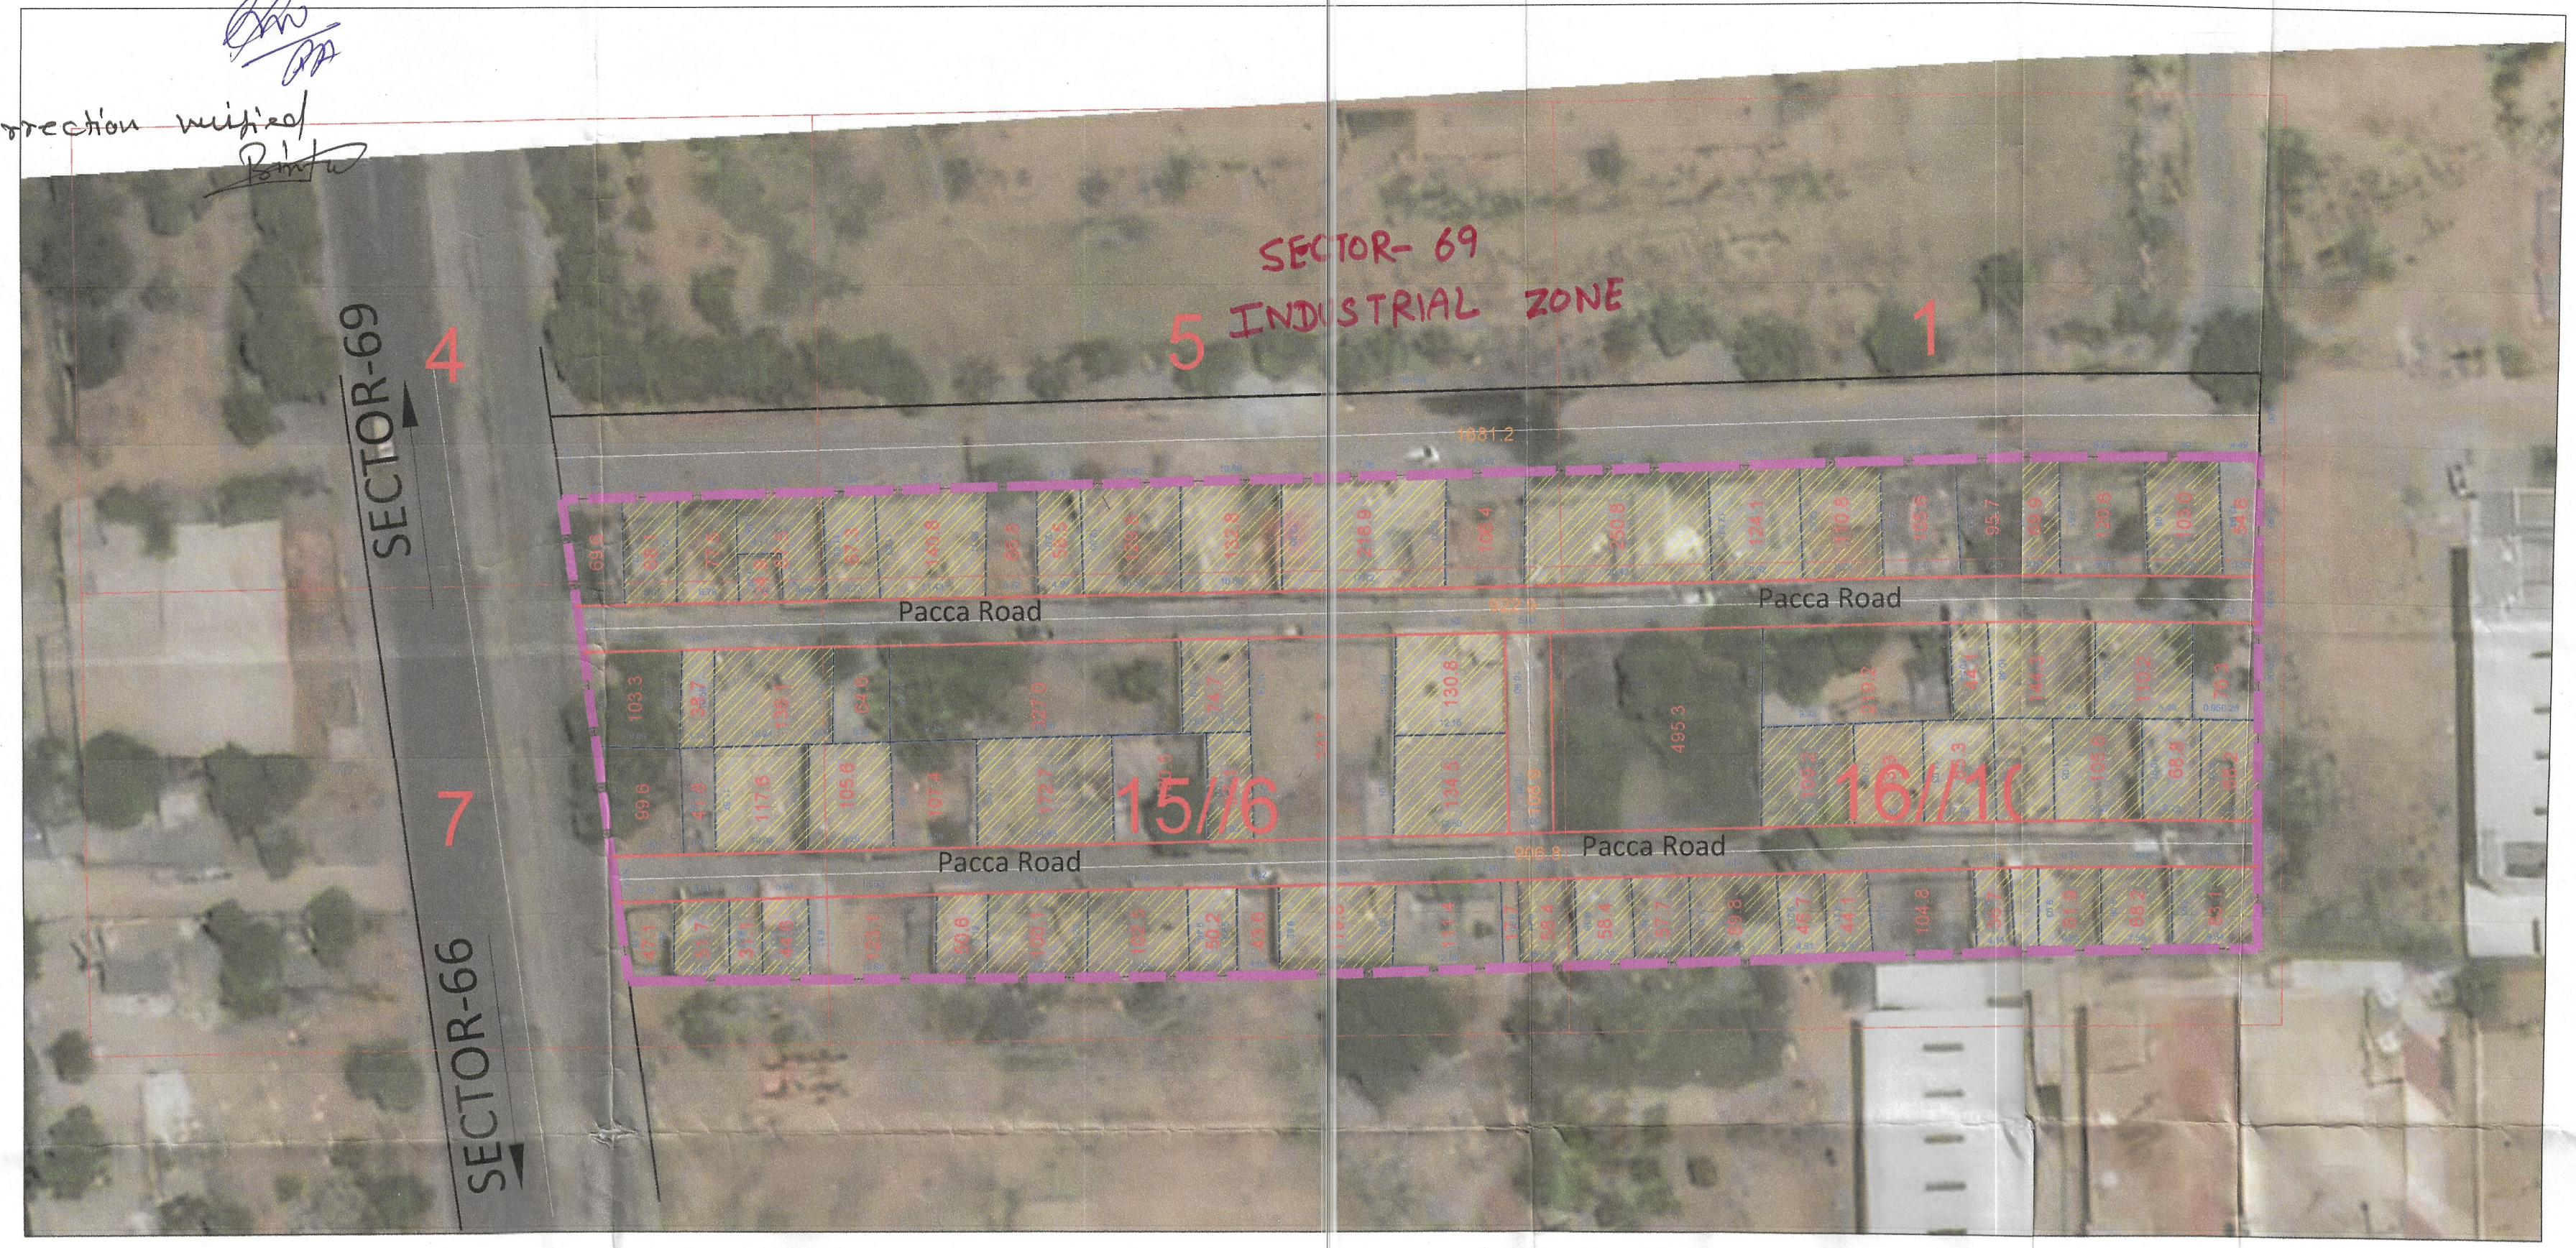

DRONE SURVEY AND LAYOUT PLAN PREPARED BY:-
PD CONSULTING ENGINEERS PVT.LTD

 hello@pdcegroup.com www.pdcegroup.com
 Red House, Behind MCD School,
 Mehrauli-Gurgaon Rd, Ghitorni, Delhi - 30

This layout plan of unauthorised colony is approved and notified by the Government vide notification no. 09/121/2023 - 4CII dated 15th December, 2023. The same be scanned for uploading on the web portal.

Checked : PDCE	Surveyor : RISHI PAL	Sheet : A1
Drawn By : NITISH KUMAR	Sht. No. :- 1 CF 1	ID-3343

NOTE:
 ALL DIMENSIONS ARE IN METERS AND AREA IN ACRES.
 DRG. NO. DTP(E)-FBD/2022/ _____ DATED _____
 LAYOUT PLAN CHECKED AND VERIFIED AT SITE BY:-
 PATWARI _____
 JUNIOR ENGG. _____
 ASSISTANT TOWN PLANNER _____
 DISTRICT TOWN PLANNER _____
 SENIOR TOWN PLANNER _____
 OFFICE-DISTRICT TOWN PLANNER(ENF), FARIDABAD TOWN & COUNTRY PLANNING DEPTT., HARYANA

PATWARI _____ KANUGO _____ SR. ARCH. _____ D.M. _____ J.E. _____ DTP _____ CTP _____ CMC _____ DIV. COMMISSIONER _____

LEGEND		Commercial Area	Industrial Area	Divider Road
Murraba Line		Built Up Area/Residential		Temple/Mosque/Church/Flag Post
Khasra Line		Vacant Land/Plot		Statue/School/Airport/Hospital/Well
Colony Boundary		Drain/Culvert / Bridge		Tin Shed
HT Line		Kaccha Road		
Sewerage Line		Pacca Road		
Water Supply Line				